

Ottawa County Remonumentation

RECORDED

LAND CORNER RECORDATION CERTIFICATE
Filing Requirement of Act 74, Mich. P.A. 1970

96 DEC 18 PM 4:54

For corners in
Ottawa

D. J. Rosema
REGISTER OF DEEDS
OTTAWA COUNTY, MI

(County)	Located In:	Corner Code #
1. Public Land Survey	T <u>7N</u> R <u>14W</u>	M-9 (SE cor. Sec. 24)
	T _____ R _____	_____
	T _____ R _____	_____
	T _____ R _____	_____
2. Property Controlling in Section	S _____ T _____ R _____	_____
	S _____ T _____ R _____	_____
3. Miscellaneous Property in Sec.	S _____ T _____ R _____	_____
	S _____ T _____ R _____	_____

Register of Deeds Stamp & File Number

4. Lot No. _____, Recorded Plat _____
5. Private Claims _____

	A	B	C	D	E	F	G	H	I	J	K	L	M
2	6		5		4		3		2		1		
3													
4	7		8		9		10		11		12		
5													
6	18		17		16		15		14		13		
7													
8	19		20		21		22		23		24		
9													
10	30		29		28		27		26		25		
11													
12	31		32		33		34		35		36		
13													

I, Maurice J. Rosema, in a field survey on Dec. 7, 19 96, do hereby certify that under requirements of P.A. 74, Michigan P.A. of 1970, the corner points mentioned in lines 1 and 2 above were in conformance with regulations and rules therefore as required in the current manual of survey instructions of the United States Department of the Interior, Bureau of Land Management or by a decree of a Court of Law and/or that the corner points mentioned in lines 3, 4 and 5 above were in conformance with the rules of the Michigan Board of Land Surveyors or by a Decree of a Court of Law; established, re-established, monumented, re-monumented, recovered, found as expressed below:

NOTE: Not more than 4 corners, all in the same town and range, may be recorded on this certificate.

A. Description of original monument and accessories and/or subsequent restoration:

M-9
GLO - 1837 by Mullett LCRC rec. in L. 1, P 215
40" W Oak - S20°W 53 lks (1972) - T iron
16" Hemlock - N23½°W 38 lks MBT pole - N30°W 61.61'
6" Pine - N40°E 52.08'
CP pole - S20°W 84.25'

Information from the files of Nederveld Associates
Iron in mon. box
Nail and MDOT tag in NW side 12"
Pine - N50°E 96.65'
PK in top G rail post - N15°W 129.18'
c/l top hydrant - S25°E 93.04'
PK in E side P pole - S20°W 106.43'

Information from the files of Tru-Line Surveying P.C.
½" copper rod in mon. box
PK nail in NW side guy pole - NE 33.26'
PK nail in top curb radius - NW 32.20'

B. Description of corner evidence found and/or method applied in restoring or reestablishing corner:

M-9
Found ½" x 18" copper rod in mon. box, replaced with 5/8" x 3' steel rod with remon. cap in mon. box
Found PK nail in top of wood guard rail post (at S end of guard rail) - N13°W 129.17'
Center of top of hydrant - S18°W 106.43'


I hereby accept this corner as a correct and accurate perpetuation of the position of the original corner.

OTAWA COUNTY
PEER APPROVED 12-9-96

M. J. Rosema

C. Description of monument for corner and accessories established to perpetuate locating the position of the corner:

M-9
½" x 3' steel rod with remon. cap in mon. box
Nail and remon. tag in top of wood guard rail post (at S end of guard rail) - N13°W 129.17'
Nail and remon. tag in SE side 6" Maple - N35°E 93.49'
Nail and remon. tag in NW side P pole - N69°E 50.40'
Center of top of hydrant - S27°E 93.00'
Nail and remon. tag in E side pole - S18°W 106.43'
Nail and remon tag in NW side P pole - S21°W 90.08'
Centerline of E-W bit. conc. road - S 30'±
On centerline of N-S bit. conc. road ±
½" rod in mon. box - S0°E 52.11

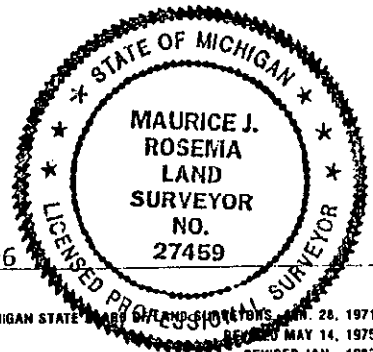

Signed by Maurice J. Rosema
Surveyor's Michigan License No. 27459

Date Dec. 7, 1996