

RECORDED

93 DEC 15 AM 9:28

*Maurice J. Rosema*  
REGISTER OF DEEDS  
OTTAWA COUNTY, MI

Ottawa County remonumentation  
LAND CORNER RECORDATION CERTIFICATE  
Filing Requirement of Act 74, Mich. P.A. 1970

For corners in

<u>Ottawa</u> (County)	Located In:	Corner Code #
1. Public Land Survey	T <u>7N</u> R <u>14W</u>	<u>M-11</u>
	T _____ R _____	_____
	T _____ R _____	_____
	T _____ R _____	_____
2. Property Controlling in Section	S _____ T _____ R _____	_____
	S _____ T _____ R _____	_____
3. Miscellaneous Property in Sec.	S _____ T _____ R _____	_____
	S _____ T _____ R _____	_____
4. Lot No. _____, Recorded Plat _____		
5. Private Claims _____		

Register of Deeds Stamp & File Number

A	B	C	D	E	F	G	H	I	J	K	L	M
2	6	5	4	3	2	1						
3												
4	7	8	9	10	11	12						
5												
6	18	17	16	15	14	13						
7												
8	19	20	21	22	23	24						
9												
10	30	29	28	27	26	25						
11												
12	31	32	33	34	35	36						
13												

I, Maurice J. Rosema, in a field survey on July 31, 19 93, do hereby certify that under requirements of P.A. 74, Michigan P.A. of 1970, the corner points mentioned in lines 1 and 2 above were in conformance with regulations and rules therefore as required in the current manual of survey instructions of the United States Department of the Interior, Bureau of Land Management or by a decree of a Court of Law and/or that the corner points mentioned in lines 3, 4 and 5 above were in conformance with the rules of the Michigan Board of Land Surveyors or by a Decree of a Court of Law; established, re-established, monumented, re-monumented, recovered, found as expressed below:

NOTE: Not more than 4 corners, all in the same town and range, may be recorded on this certificate.

A. Description of original monument and accessories and/or subsequent restoration:

M-11 Clapp - per L.C.R.C. recorded in Liber 3, Page 107 "T" iron MDSH tag in P. pole - SW. 64.47' Iron - S. 43.50' Iron - S. 48.00' Street sign - ESE. 32.93' 18" Maple - WNW. 93.32'	Joiner - 1991 per L.C.R.C. recorded in Liber 6, Page 164 C.I. monument Section corner (RR. spike) - S 48.00' P. pole - SW. 72.50' Centerline of Mich. Bell post - NW. 57.55' P. pole - NE. 113.05' Street sign - SE. 32.92'
---	---


B. Description of corner evidence found and/or method applied in restoring or reestablishing corner:

M-11 Found C.I. monument in monument box  
Georgetown corner (RR.spike with + cut) - S00°E 48.00'  
Found nail in W. side P. pole - N21°E 113.64'  
Found P.K. nail in NW. side P. pole - S41°W 72.77'  
Center of street sign - S36°E 33.05'

I hereby accept this corner as a correct and accurate perpetuation of the position of the original section corner.

C. Description of monument for corner and accessories established to perpetuate locating the position of the corner:

M-11 C.I. monument in monument box  
Set nail and O.C. remon. tag in top of fence post - N44°W 57.18'  
Set nail and O.C. remon. tag in NW. side P. pole - S41°W 72.77'  
Set nail and O.C. remon. tag in W. side P. pole - N21°E 113.64'  
Set nail and O.C. remon. tag in S side 12" Ash - N74°W 105.04'  
Georgetown corner (RR spike with + cut) - S00°E 48.00'

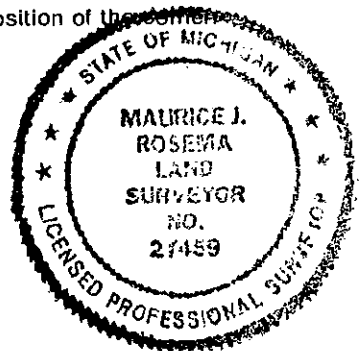

Signed by *Maurice J. Rosema* Date October 02, 1993  
Maurice J. Rosema - Tru-Line Surveying  
Surveyor's Michigan License No. 27459