

1823

Ottawa County remonumentation
LAND CORNER RECORDATION CERTIFICATE
Filing Requirement of Act 74, Mich. P.A. 1970

RECORDED

93 DEC 15 AM 9:28

Register of Deeds
REGISTER OF DEEDS
OTTAWA COUNTY, MI

For corners in **COMMISSION**
Ottawa
(County)

Located In:	Corner Code #
T <u>7N</u> R <u>14W</u>	<u>M-13</u>
T _____ R _____	_____
T _____ R _____	_____
T _____ R _____	_____
S _____ T _____ R _____	_____
S _____ T _____ R _____	_____
S _____ T _____ R _____	_____

Register of Deeds Stamp & File Number

4. Lot No. _____, Recorded Plat _____
5. Private Claims _____

	A	B	C	D	E	F	G	H	I	J	K	L	M
2	6		5		4		3		2		1		
3													
4	7		8		9		10		11		12		
5													
6	13		17		16		15		14		13		
7													
8	19		20		21		22		23		24		
9													
10	30		29		28		27		26		25		
11													
12	31		32		33		34		35		36		
13													

I, Maurice J. Rosema, in a field survey on July 31, 19 93, do hereby certify that under requirements of P.A. 74, Michigan P.A. of 1970, the corner points mentioned in lines 1 and 2 above were in conformance with regulations and rules therefore as required in the current manual of survey instructions of the United States Department of the Interior, Bureau of Land Management or by a decree of a Court of Law and/or that the corner points mentioned in lines 3, 4 and 5 above were in conformance with the rules of the Michigan Board of Land Surveyors or by a Decree of a Court of Law; established, re-established, monumented, re-monumented, recovered, found as expressed below:

NOTE: Not more than 4 corners, all in the same town and range, may be recorded on this certificate.

A. Description of original monument and accessories and/or subsequent restoration:

M-13
MVK - 1974 per L.C.R.C. recorded in Liber 2, Page 477
Iron
Spk. in SW. side 12" Maple - SE. 54.14'
Spk. in SE. side T. Pole - SW. 53.73'
Corner church building fndn. - SSW. 141.73'
Center of SW. iron of church sign post - 70.36'

Joiner - 1991 per L.C.R.C. recorded in Liber 6, Page 163
C.I.M. in mon. box
P. Pole - SW. 45.33'
Guy Pole - SE. 114.94'
5" Poplar - NW. 109.97'
centerline sign post - NE. 70.35'


B. Description of corner evidence found and/or method applied in restoring or reestablishing corner:

M-13 Found C.I. monument in monument box
NE. corner church building fndn. - S36°W 141.73'
Center of base of SW. iron church sign post - N40°E 70.35'
Nail in SE. side P. Pole - S46°W 45.30'
Nail in S. side guy pole - S70°E 114.92'
Nail in NE. side 7" Poplar - N55°W 109.93'

I hereby accept this corner as a correct and accurate perpetuation of the position of the original section corner.

C. Description of monument for corner and accessories established to perpetuate locating the position of the corner:

M-13 C.I. monument in monument box
Set nail and O.C. remon. tag in NW. side guy pole - N46°E 48.18'
Set nail and O.C. remon. tag in S. side guy pole - S70°E 114.92'
Set nail and O.C. remon. tag in NE. side 7" Poplar - N55°W 109.93'
Set nail and O.C. remon. tag in SE. side P. pole - S46°W 45.30'
At centerline X of bit. conc. roads N-S and E-W

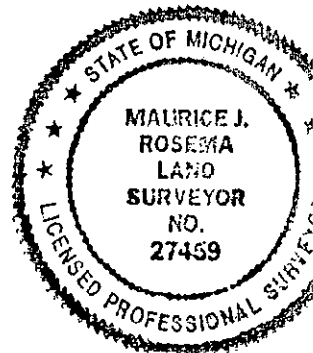

Signed by Maurice J. Rosema Date Oct. 02, 1993
Surveyor's Michigan License No. 27459 - Tru-Line surveying