

FEB 24 2000

OTTAWA COUNTY REMONUMENTATION PROGRAM
LAND CORNER RECORDATION CERTIFICATE
Filing Requirement of Act 74, Mich. P.A. 1970

RECORDED

99 DEC -2 PM 1:13


SECTION

Larry D. [Signature]
REGISTER OF DEEDS
OTTAWA COUNTY, MI

For corners in

OTTAWA (County) Located In: ROBINSON (Township) Corner Code #A-2

1. Public Land Survey	T	7N	R15W	A-2
	T		R	WEST 1/4 CORNER
	T		R	SECTION 6
	T		R	
	T		R	
2. Property Controlling in Section	S	T	R	COMMON COR.
	S	T	R	
3. Miscellaneous Property in Sec.	S	T	R	
	S	T	R	

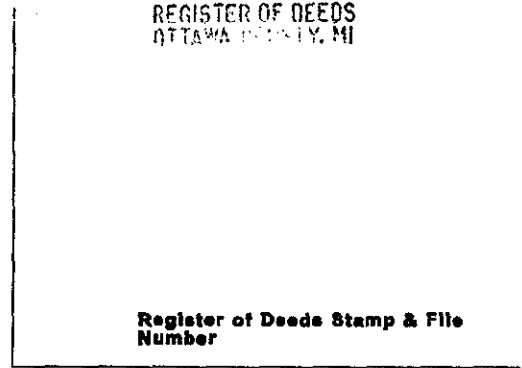

4. Lot No. _____, Recorded Plat _____
5. Private Claims _____


A	B	C	D	E	F	G	H	I	J	K	L	M
1												
2	6	5	4	3	2	1						
3												
4	7	8	9	10	11	12						
5												
6	18	17	16	15	14	13						
7												
8	19	20	21	22	23	24						
9												
10	30	29	28	27	26	25						
11												
12	31	32	33	34	35	36						
13												

I, Robert E. Lemke, surveyor, in a field survey on September 7, 1999 do hereby state that under requirements of P.A. 74, Michigan P.A. of 1970, the corner points mentioned in lines 1 and 2 above were in conformance with regulations and rules therefore as required in the current manual of survey instructions of the United States Department of the Interior, Bureau of Land Management or by a decree of a Court of Law and /or that the corner points mentioned in lines 3, 4 and 5 above were in conformance with the rules of the Michigan Board of Land Surveyors or by a Decree of a Court of Law; established, reestablished, monumented, recovered, found as expressed below:

NOTE: Not more than 2 corners, all in the same town and range, may be recorded on this certificate.

- A. Description of original monument and accessories and/or subsequent restoration: SEE BACK OF SHEET FOR CORNER HISTORY
- B. Description of corner evidence found and/or method applied in restoring or reestablishing corner:

A-2
FOUND 2" DIA. ALUMINUM CAP STAMPED "OTTAWA COUNTY REMONUMENTATION SURVEY MARKER"
TOP CENTER NUT OF FIRE HYDRANT N.W. 49.81'
FOUND NAIL ON SOUTH SIDE OF 36" OAK 6" ABOVE GROUND. N.E. 115.04'
FOUND NAIL ON EAST SIDE OF 16" MAPLE 12" ABOVE GROUND. S.E. 72.49'
MEASURED TO CENTER OF WOOD POWER POLE (DID NOT FIND WITNESS) S.W. 40.4'
FOUND NAIL IN NORTH SIDE OF WOOD POWER POLE 24" ABOVE GROUND. S.W. 130.95'

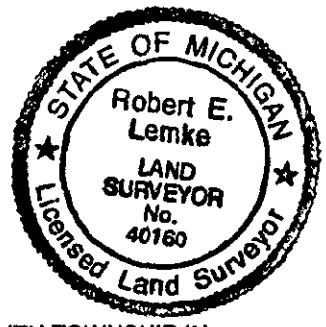

THIS CORNER(A-2) WAS DETERMINED TO BE COMMON WITH M-2, E 1/4 COR. OF SECTION 1, GRAND HAVEN TOWNSHIP IN REMON LIBER 3, PAGE 4 BY TOM JOINER IN DECEMBER OF 1995. M-2 WAS PEER APPROVED ON NOVEMBER 20, 1995. This position not established by original government surveyors. This monument is accepted as the best available evidence of the position of the corner.

C. Description of monument for corner and accessories established to perpetuate locating the position of the corner:

A-2
OTTAWA COUNTY REMON CAP #21272
WHICH IS 3" BELOW THE TOP OF THE MONUMENT BOX.

TOP CENTER NUT OF FIRE HYDRANT
SET NAIL WITH OTTAWA COUNTY REMON. TAG ON SOUTH SIDE OF 48" TWIN OAK 1' ABOVE GROUND. N.20°W. 49.81'
SET NAIL WITH OTTAWA COUNTY REMON. TAG ON NORTH SIDE OF 36" OAK 1' ABOVE GROUND. N.50°W. 105.87'
SET NAIL WITH OTTAWA COUNTY REMON. TAG ON EAST SIDE OF 16" MAPLE 1' ABOVE GROUND. N65°E. 115.17'
SET NAIL WITH OTTAWA COUNTY REMON. TAG ON EAST SIDE OF WOOD POWER POLE 1' ABOVE GROUND. S.30°E. 72.34'
ON CENTERLINE OF 144TH AVENUE AND CORNER IS 0.6' NORTH OF THE CENTERLINE OF MERCURY DRIVE S.55°W. 40.25'
A1 TO A2(T7N, R15W) IS 2696 AS SHOWN ON THE LCRC RECORDED FOR M-13 T8N, R16W.
A2-A3(T7N, R15W) PER SDI MEASURE IS 2647.42'.

2696 OTTAWA COUNTY
SDI 11/15/99

OCCUPATION LINE (CONSISTING OF TREE LINE AND CHAIN LINK FENCE) IS 1324' +/- SOUTH OF A-2 (EAST RUNNING)

Signed by Robert E. Lemke
For SDI CONSULTANTS, LTD

Date 11-15-1999

Surveyor's Michigan License No. 40160

\$11.00 CORNER
Reprint #64945

SEE BACK

FEB 24 2000

SECTION

OTTAWA COUNTY
ROBINSON TOWNSHIP
TOWN 7 NORTH, RANGE 15 WEST
A-2

A. Description of original monument and accessories and/or subsequent restoration

-G.L.O.
DID NOT SET

-OTTAWA COUNTY ROAD COMMISSION NOTES
FOUND 12-10-27 (OSNER)
N. 40° W. 39.3' TO CORNER OF FENCE
S. 40° W. 41.5' TO ST. SIGN

FOUND 4-23-63 (J.J.K.)
"T" IRON
30" T. OAK N.W. 61.3'
36" B. OAK NORTH 91.3'
40" B. OAK S.E. 72'
70' S.E. TO NORTH PILLAR OF FILLING STATION

FOUND GAS PIPE (NO DATE OR INITIALS)
16" R. OAK S.W. 53.9'
16" R. OAK S.E. 49.4'
6" APPLE N.E. 60.6'

-THOMAS JOINER, LAND CORNER RECORDATION CERTIFICATE, LIBER 6 PAGE 128, RECORDED: 3-7-91
FOUND ANGLE IRON IN MON. BOX.

C/L HYDRANT	NW	49.73
36" OAK	NE	115.16
TELE. POLE	SE	108.43
PP	SW	40.43

-THOMAS JOINER, RECORDED BOUNDARY SURVEY, LIBER 8 PAGE 552, DATED: 12/1/95
SHOWS NO WITNESSES

-FIELD NOTES, JOB #5155 FROM JOINER ENGINEERING
A-3 NORTH TO A-2 = N02°19'35"E 2647.76'