

**SURVEY &
REMONUMENTATION**

DEC 01 1998

**OTTAWA COUNTY REMONUMENTATION
LAND CORNER RECORDATION CERTIFICATE
Filing Requirement of Act 74, Mich. P.A. 1970**

For corners in **SECTION**

<u>Ottawa</u> <small>(County)</small>	Located In:	Corner Code #
1. Public Land Survey	T <u>7</u> N R <u>15</u> W	<u>B-1</u>
	T _____ R _____	_____
	T <u>8N</u> R <u>15W</u>	<u>B-13</u>
	T _____ R _____	_____
2. Property Controlling in Section	S _____ T _____ R _____	North 1/4 corner
	S _____ T _____ R _____	Section 6
3. Miscellaneous Property in Sec.	S _____ T _____ R _____	Crockery Twp
	S _____ T _____ R _____	_____

RECORDED
98 JUL 24 PM 1:45

Gary Hillman
REGISTER OF DEEDS
OTTAWA COUNTY, MI

Register of Deeds Stamp & File Number

4. Lot No. _____, Recorded Plat _____
5. Private Claims _____

I, Steve Lampen, in a field survey on June 10 19 98, do hereby certify that under requirements of P.A. 74, Michigan P.A. of 1970, the corner points mentioned in lines 1 and 2 above were in conformance with regulations and rules therefore as required in the current manual of survey instructions of the United States Department of the Interior, Bureau of Land Management or by a decree of a Court of Law and/or that the corner points mentioned in lines 3, 4 and 5 above were in conformance with the rules of the Michigan Board of Land Surveyors or by a Decree of a Court of Law; established, re-established, monumented, re-monumented, recovered, found as expressed below:

A	B	C	D	E	F	G	H	I	J	K	L	M
1	●											
2	6	5	4	3	2	1						
3												
4	7	8	9	10	11	12						
5												
6	18	17	16	15	14	13						
7												
8	19	20	21	22	23	24						
9												
10	30	29	28	27	26	25						
11												
12	31	32	33	34	35	36						
13												

NOTE: Not more than 4 corners, all in the same town and range, may be recorded on this certificate.

A. Description of original monument and accessories and/or subsequent restoration:

B-1 Not monumented by the original survey	GLO Plat C-1 to B-1 = 40.00 ch. GLO - T8N, R15W C-13 to B-13 = 40.00 ch. B-13 to A-13 = 39.30 ch.	Surveys by Peck C-1 to B-1 = 40.00 ch. B-1 to A-1 = 40.23 ch. B-1 to B-2 = 39.80 ch. C-13, T8N, R15W to B-13 = 40.00 ch. B-13 to A-13 = 40.23 ch.
---	---	--

B. Description of corner evidence found and/or method applied in restoring or reestablishing corner:

B-1
B-1 was not monumented in the original GLO survey.
Historically C-1 T7NR15W has been used as common with C-13 T8NR15W.
Peck held C-1 and C-13 common and also held B-1 and B-13 common.
Calculated the North and South position of B-1 by extending the Section line West from C-1 thru irons found 1326.4 ft and 2204.2 ft West of C-1.
Calculated East and West position of C-1 by proportioning Peck's distances of C-1 to B-1 = 40.00 ch. and B-1 to A-1 = 40.23 ch. Peck = 80.23 ch. = 5295.18 ft. Measure = 5297.24 ft.
Calculated position is on line (± 0.3ft) with historical monument at B-2 and the historical SW corner of the NW1/4 NE1/4 Section 6.
See sketch on back.
Set an Ottawa County Remonumentation iron and cap and is accepted as the best position of the corner.


PA. 345 OTTAWA COUNTY

PREPARED BY 6-15-98
[Signature]

C. Description of monument for corner and accessories established to perpetuate locating the position of the corner:

B-1
Ottawa County Remonumentation Iron and Cap.
B-1 T7NR15W is common with B-13 T8NR15W
Azimuth = Michigan State Plane Grid Direction

Remonumentation tag in SW side	6" Poplar	142° 48'	115.17
Remonumentation tag in SW side	8" Willow	133° 38'	163.84
Remonumentation tag in NE side	10" Willow	158° 06'	180.54
Pk nail	NW side	Light pole	193° 07'
			163.70

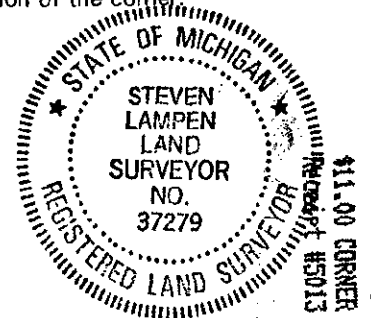

Signed by Steven Lampen Date JULY 20, 1998
Surveyor's Michigan License No. 37279

FORM APPROVED BY MICHIGAN STATE BOARD OF LAND SURVEYORS, JAN. 28, 1971

REVISED MAY 14, 1975
REVISED JAN., 1983
ADAPTED FOR WORD PROCESSING MARCH, 1993

SURVEY &
REMONUMENTATION

DEC 01 1998

SECTION

