

RECORDED

FEB 24 2000

OTTAWA COUNTY REMONUMENTATION PROGRAM
LAND CORNER RECORDATION CERTIFICATE
Filing Requirement of Act 74, Mich.P.A. 1970

99 DEC -2 PM 1:12

SECTION

Ray S. Hill
REGISTER OF DEEDS
OTTAWA COUNTY, MI

For corners in

OTTAWA
(County)

Located in: ROBINSON
(Township)

Corner Code #B-5

1. Public Land Survey	T	<u>7N</u>	<u>R15W</u>	N1/4 OF Sec. 18
	T	_____	_____	_____
	T	_____	_____	_____
	T	_____	_____	_____
2. Property Controlling in Section	S	_____	_____	_____
	S	_____	_____	_____
3. Miscellaneous Property in Sec.	S	_____	_____	_____
	S	_____	_____	_____

Register of Deeds Stamp & File Number

4. Lot No. _____, Recorded Plat _____
5. Private Claims _____

I, Robert E. Lemke, surveyor, in a field survey on SEP. 8, 1999 do hereby state that under requirements of P.A. 74, Michigan P.A. of 1970, the corner points mentioned in lines 1 and 2 above were in conformance with regulations and rules therefore as required in the current manual of survey instructions of the United States Department of the Interior, Bureau of Land Management or by a decree of a Court of Law and /or that the corner points mentioned in lines 3, 4 and 5 above were in conformance with the rules of the Michigan Board of Land Surveyors or by a Decree of a Court of Law; established, reestablished, monumented, recovered, found as expressed below:

A	B	C	D	E	F	G	H	I	J	K	L	M
1												
2	6		5		4		3		2		1	
3												
4	7		8		9		10		11		12	
5												
6	18		17		16		15		14		13	
7												
8	19		20		21		22		23		24	
9												
10	30		29		28		27		26		25	
11												
12	31		32		33		34		35		36	
13												

NOTE: Not more than 2 corners, all in the same town and range, may be recorded on this certificate.

A. Description of original monument and accessories and/or subsequent restoration:

SEE BACK OF SHEET FOR CORNER HISTORY

B. Description of corner evidence found and/or method applied in restoring or reestablishing corner:

FOUND CAST IRON MONUMENT IN MONUMENT BOX. MONUMENT IS 6" BELOW SURFACE AND IS IN CENTERLINE OF LINCOLN STREET. FITS OCCUPATION TO NORTH AND SOUTH.

FOUND THE FOLLOWING WITNESS'S:

RECORD IS P.K NAIL IN SE FACE 18" OAK	NE	34.84	MEASURED IS 34.85' TO DOUBLE HEADED NAIL
RECORD IS IRON	SOUTH	33.00'	MEASURED IS 33.00' TO ANGLE IRON
P.K. NAIL IN NW FACE 12" PINE	SW	108.55	MEASURED IS 108.45 TO P.K. IN 19" PINE
P.K. NAIL IN SW FACE 12" TWIN OAK	NW	41.97	MEASURED IS 41.91' TO TWIN OAK

1) And is accepted as a careful and faithful perpetuation of the position of the original corner.

C. Description of monument for corner and accessories established to perpetuate locating the position of the corner:

B-5 CAST IRON MONUMENT IN MONUMENT BOX.

SET NAIL AND OTTAWA COUNTY REMON. TAG IN S.E. FACE OF 18" OAK	N 45°E	34.85'	(2.5') ABOVE GRADE
SET NAIL AND OTTAWA COUNTY REMON. TAG IN N.W. FACE OF 19" PINE	S 45°W	108.43'	(2') ABOVE GRADE
SET NAIL AND OTTAWA COUNTY REMON. TAG IN S.W. FACE OF 14"/12" TWIN OAK	N 45°W	41.91'	(2.5') ABOVE GRADE
ANGLE IRON	SOUTH	33.00'	


ON EXTENSION SOUTH OF SPLIT RAIL FENCE RUNNING NORTH
ON EXTENSION NORTH OF WIRE FENCE RUNNING SOUTH
ON PHYSICAL CENTERLINE OF LINCOLN STREET

Signed by Robert E. Lemke

Date 9-20-1999

For SDI CONSULTANTS, LTD

Surveyor's Michigan License No. 40160

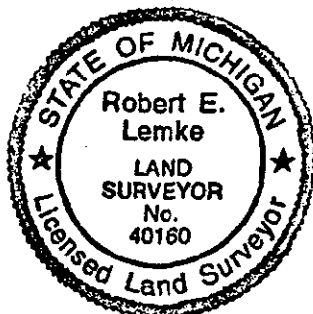

SEE BACK

FORM APPROVED BY MICHIGAN STATE BOARD OF PROFESSIONAL SURVEYORS
JAN. 28, 1971 REVISED MAY 14, 1975
REVISED JAN., 1983
REVISED OCT., 1995

\$11.00 CORNER
Receipt #64945

FEB 24 2000

OTTAWA COUNTY
ROBINSON TOWNSHIP
TOWN 7 NORTH, RANGE 15 WEST

SECTION

B-5

A. Description of original monument and accessories and/or subsequent restoration

-G.L.O.

40.0 SET 1/2 MILE POST
PINE 20 S21W 4
W OAK N21E 26

A) DAVID GREER, L.C.R.C. RECORDED LIBER 1 PAGE 297, DATED: 02-11-1972

FOUND IRON PIPE

1. NAIL IN FACE OF TWIN 12" OAK NW 100.97'
2. NAIL IN FACE OF 14" OAK NE 67.3'
3. NAIL IN FACE OF TEL. POLE NE 85.05'
4. NAIL IN FACE OF P.P. SE 47.10'
5. IRON SOUTH 33.00'

B) THOMAS JOINER, L.C.R.C. RECORDED LIBER 5 PAGE 375, DATED: 6-21-89

FD IRON PIPE

SET CIM

1. P.K NAIL IN SE FACE 18" OAK NE 34.84
2. P.K. NAIL IN SW FACE 12" TWIN OAK NW 41.97
3. P.K. NAIL IN NW FACE 12" PINE SW 108.55
4. P.K. NAIL IN SW FACE PP SSE 47.53

C) CARL ENGLERT JR., RECORDED BOUNDARY SURVEY, LIBER 7 PAGE 708, DATED: 9-14-90

- (1) NAIL IN S.E. FACE 18" OAK
- (2) NAIL IN S.W. FACE 12" TW OAK NO BEARINGS/DISTANCES SHOWN
- (3) NAIL IN N.W. FACE 12" PINE
- (4) NAIL IN S.W. FACE P.P.
- (5) WEST TO A-5 = N89°24'10"W 2815.48'

D) CARL ENGLERT JR., RECORDED BOUNDARY SURVEY, LIBER 8 PAGE 296, DATED: 9-14-90

CIM

- (1) NAIL IN S.E. FACE 18" OAK
- (2) NAIL IN S.W. FACE 12" TW OAK NO BEARINGS/DISTANCES SHOWN
- (3) NAIL IN N.W. FACE 12" PINE
- (4) NAIL IN S.W. FACE P.P.
- (5) WEST TO A-5 = N89°24'10"W 2815.48'

E) THOMAS JOINER, RECORDED BOUNDARY SURVEY, LIBER 7 PAGE 762, DATED: 4-23-93

FD. 1/2" IRON MON. BOX

1. NW. P.P. 103.11'
2. NE. P.P. 71.69'
3. SE. P.P. 47.58'
4. WEST TO A-5 = S89°23'35"E 2815.48'