

DEC 01 1998

SECTION

OTTAWA COUNTY REMONUMENTATION  
LAND CORNER RECORDATION CERTIFICATE  
Filing Requirement of Act 74, Mich. P.A. 1970

For corners in

<u>Ottawa</u> (County)	Located In:	Corner Code #
1. Public Land Survey	T 7 N R 15 W T _____ R _____ T 8 N R 15 W T _____ R _____	C-1 C-13 NW corner Section 5 Robinson Twp
2. Property Controlling in Section	S _____ T _____ R _____ S _____ T _____ R _____	
3. Miscellaneous Property in Sec.	S _____ T _____ R _____ S _____ T _____ R _____	
4. Lot No. _____, Recorded Plat _____		
5. Private Claims _____		

RECORDED

98 JUL 24 PM 1:44

*Ray [Signature]*  
REGISTER OF DEEDS  
OTTAWA COUNTY, MI

Register of Deeds Stamp & File Number

I, Steve Lampen, in a field survey on May 19 98, do hereby certify that under requirements of P.A. 74, Michigan P.A. of 1970, the corner points mentioned in lines 1 and 2 above were in conformance with regulations and rules therefore as required in the current manual of survey instructions of the United States Department of the Interior, Bureau of Land Management or by a decree of a Court of Law and/or that the corner points mentioned in lines 3, 4 and 5 above were in conformance with the rules of the Michigan Board of Land Surveyors or by a Decree of a Court of Law; established, re-established, monumented, re-monumented, recovered, found as expressed below:

	A	B	C	D	E	F	G	H	I	J	K	L	M
1													
2	6		5		4		3		2		1		
3													
4	7		8		9		10		11		12		
5													
6	18		17		16		15		14		13		
7													
8	19		20		21		22		23		24		
9													
10	30		29		28		27		26		25		
11													
12	31		32		33		34		35		36		
13													

NOTE: Not more than 4 corners, all in the same town and range, may be recorded on this certificate.

A. Description of original monument and accessories and/or subsequent restoration:

C-1 GLO-Britain May 19, 1832 North between Sections 5 and 6 78.57 North boundary 26 East of post and set corner to Sections 5 and 6 Pine 30 S 39 E 13 DO 24 S 68 W 36	Peck - Pine 24 S 80 1/2 E 70 SW Cor. Sc. Ho. N11W 70.2  Peck for C-13 T8NR15W Pine 24 S 80 1/2 E 70 Oak 16 N 69 1/2 E 80	LCRC-L5 P 373 - Joiner 1989 fount "T" iron fence post Set cast iron monument Power pole NE 55.79 Tel. pole SE 91.60 12" pine SW 78.93 6" Oak NW 112.87
---	--	--

B. Description of corner evidence found and/or method applied in restoring or reestablishing corner:

C-1 Found cast iron monument in monument box.  
SW Cor. Sc. Ho. N 11 W 70.2  
Power pole NE 55.79  
Tel. Pole SE 91.60  
12" Pine SW 78.93  
6" Oak NW 112.87

P.A. 345 OTTAWA COUNTY  
PEER APPROVED 6-15-98  
*[Signature]*

Historically this corner has been held as common with C-13 T8NR15W by Peck and others

C-1 T7NR15W is common with C-13 T8NR15W


Found cast iron monument is accepted as the best position of the corner

C. Description of monument for corner and accessories established to perpetuate locating the position of the corner:

C-1 Cast iron monument in monument box C-1 T7NR15W is common with C-13 T8NR15W

Azimuth = Michigan State Plane Grid Direction

Remonumentation tag North side	Power pole	110° 29'	91.51
SE corner old school foundation		9° 27'	71.69
SW corner old school foundation		349° 24'	70.28
NE corner house, brick		227° 11'	100.73
SW corner house foundation		58° 08'	167.36
NW corner house, brick		238° 05'	131.93

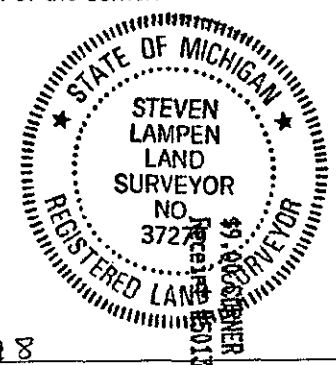

Signed by Steven Lampen Date July 20, 1998  
Surveyor's Michigan License No. 37279

FORM APPROVED BY MICHIGAN STATE BOARD OF LAND SURVEYORS, JAN. 28, 1971

REVISED MAY 14, 1975  
REVISED JAN., 1983  
ADAPTED FOR WORD PROCESSING MARCH, 1993