

**SURVEY & REMONUMENTATION**

FEB 27 1998

**SECTION**

**OTTAWA COUNTY REMONUMENTATION  
LAND CORNER RECORDATION CERTIFICATE  
Filing Requirement of Act 74, Mich. P.A. 1970**

For corners in

Ottawa

(County)

Located in:  
Robinson  
Township

Corner Code #

1. Public Land Survey

T 7N R 15W

C-2

West 1/4 corner  
Section 5

2. Property Controlling in Section

S T R

3. Miscellaneous Property in Sec.

S T R

S T R

4. Lot No. \_\_\_\_\_, Recorded Plat \_\_\_\_\_  
5. Private Claims \_\_\_\_\_

RECORDED

97 OCT 30 AM 11:00

*Delena Gant*

Register of Deeds  
Ottawa County, MI

Register of Deeds Stamp & File Number

I, Carl P. Englert, in a field survey on 3/3, 1997 do hereby state that under requirements of P.A. 74, Michigan P.A. of 1970, the corner points mentioned in lines 1 and 2 above were in conformance with regulations and rules therefore as required in the current manual of survey instructions of the United States Department of the Interior, Bureau of Land Management or by a decree of a Court of Law and/or that the corner points mentioned in lines 3, 4 and 5 above were in conformance with the rules of the Michigan Board of Land Surveyors or by a Decree of a Court of Law; established, re-established, monumented, recovered, found as expressed below:

NOTE: Not more than 2 corners, all in the same town and range, may be recorded on this certificate.

A	B	C	D	E	F	G	H	I	J	K	L	M
1												
2	6	5	4	3	2	1						
3												
4	7	8	9	10	11	12						
5												
6	18	17	16	15	14	13						
7												
8	19	20	21	22	23	24						
9												
10	30	29	28	27	26	25						
11												
12	31	32	33	34	35	36						
13												

A. Description of original monument and accessories and/or subsequent restoration:

C-2 1/4 corner common to Sections 5 and 6

G.L.O. 1832 Calvin Britain

Set 1/2 Mile Post

Pine 15" N39°W 12 links

Pine 12" S39°E 10 links

LCRC Liber 4, Page 61

C-2 Found 1" Sq. Bar

Set Cast Iron Monument Inscribed "Section Corner"

Q 12" Spruce SE 37.59'

Q Gravel Road E 9'±

Q 20" Black Oak NW 85.40'

Concrete Monument W 33.0'

Q 7" Red Pine SW 37.97' (4-25-80)

B. Description of corner evidence found and/or method applied in restoring or reestablishing corner:

C-2 1/4 corner common to Sections 5 and 6

Found 4" Harrison Cast Iron Monument in Gravel Asphalt Road 1.1' deep

Found Concrete Monument West 33'

Found 12" Spruce SE 37.59'

Found 26" Oak NW 85.4'

PA. 345 OTTAWA COUNTY

FEER APPROVED 9-15-97

Accepted as a careful and faithful perpetuation of the position of the original corner.

C. Description of monument for corner and accessories established to perpetuate locating the position of the corner:

C-2 1/4 corner common to Sections 5 and 6


O.C. Remon Tag & Nail in E Side 30" Oak S8°W 75.87'

O.C. Remon Tag & Nail in W Side 15" Spruce S39°E 50.51'

O.C. Remon Tag & Nail in SE Side 15" Spruce N44°E 53.38'

O.C. Remon Tag & Nail in SW Side 26" Oak N33°W 85.33'

Concrete Monument N88°W 32.93'

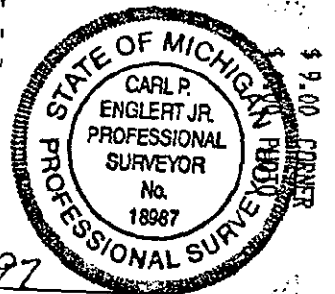

Signed by Carl P. Englert Jr.  
Surveyor's Michigan License No. \_\_\_\_\_

Date 9/15/1997