

**SURVEY &  
REMONUMENTATION**

APR 25 1995

OTTAWA COUNTY REMONUMENTATION  
LAND CORNER RECORDATION CERTIFICATE  
Filing Requirement of Act 74, Mich. P.A. 1970

RECORDED

94 DEC -8 PM 12: 35

or corners in **COMMISSION**

*Richard B. ...*  
REGISTER OF DEEDS  
OTTAWA COUNTY, MI

Ottawa (County) Located In: Robinson Twp. Corner Code #  
Public Land Survey T 7N R 15W C-9  
T \_\_\_ R \_\_\_ NW Corner  
T \_\_\_ R \_\_\_ Section 29  
T \_\_\_ R \_\_\_  
Property Controlling S \_\_\_ T \_\_\_ R \_\_\_  
in Section S \_\_\_ T \_\_\_ R \_\_\_  
Miscellaneous S \_\_\_ T \_\_\_ R \_\_\_  
Property in Sec. S \_\_\_ T \_\_\_ R \_\_\_

Register of Deeds Stamp & File Number

Lot No. \_\_\_\_\_, Recorded Plat \_\_\_\_\_  
Private Claims \_\_\_\_\_

	A	B	C	D	E	F	G	H	I	J	K	L	M
2	6	5	4	3	2	1							
3													
4	7	8	9	10	11	12							
5													
6	18	17	16	15	14	13							
7													
8	19	20	21	22	23	24							
9													
10	30	29	28	27	26	25							
11													
12	31	32	33	34	35	36							
13													

Carl P. Englert, in a field survey on April 04, 19 94,  
do hereby certify that under requirements of P.A. 74, Michigan P.A. of 1970, the corner points mentioned  
in lines 1 and 2 above were in conformance with regulations and rules therefore as required in the  
current manual of survey instructions of the United States Department of the Interior, Bureau of Land  
Management or by a decree of a Court of Law and/or that the corner points mentioned in lines 3, 4 and 5  
above were in conformance with the rules of the Michigan Board of Land Surveyors or by a Decree of a  
Court of Law; established, re-established, monumented, re-monumented, recovered, found as  
expressed below:

**NOTE: Not more than 4 corners, all in the same town and range, may be recorded  
on this certificate.**

Description of original monument and accessories and/or subsequent restoration:  
C-9 corner common to Sections 19, 20, 29 & 30  
Original gov't corner set May, 1832  
by Calvin Britain D.S.

L.C.R.C. Liber 4, Page 307  
C-9 Set Cast Iron Monument  
Hole Top Corr. Culv. SW 36.97'  
Hole Top Corr. Culv. SE 38.58'  
14" Cherry NE 60.52'  
⊕ Joint M-45 N 88.95'

Set Corner  
Tamarack 6" N79°W 2.10 Chains  
Do 10" S10°E 4.54 Chains

(See Back of Page)

Description of corner evidence found and/or method applied in restoring or reestablishing corner:

C-9 corner common to Sections 19, 20, 29 & 30  
Found 4" Harrison Cast Iron Mon. 4'+/- W. of ⊕ gravel road 4" Deep  
Found Hole Top Corr. Culv. SW 36.97'  
Found Hole Top Corr. Culv. SE 38.52'  
Found 14" Cherry NE 60.52'  
⊕ M-45 89' +/- North


P.A. 345 OTTAWA COUNTY  
PEER APPROVED 11/21/94

*Richard D. Medwell*

Accepted as a careful and faithful perpetuation of the  
position of the original corner.

Description of monument for corner and accessories established to perpetuate locating the position of the corner:

C-9 corner common to Sections 19, 20, 29 & 30  
4" Harrison Cast Iron Monument  
O.C. Remon Tag & Nail in SW side P.P. N51°W 270.03'  
O.C. Remon Tag & Nail in NW side P.P. N49°E 82.39'  
Hole Punched in E. end C.M.P. S53°E 38.57'  
Hole Punched in W. end C.M.P. S52°W 37.00'

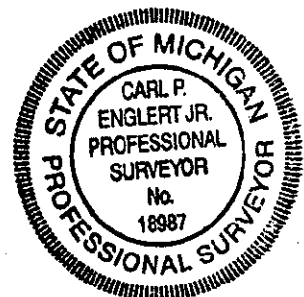

Signed by Carl P. Englert Jr.  
Surveyor's Michigan License No. 18987

Date 11/21/94

L.C.R.C. Liber 1, Page 170

Found Iron Pipe

N.W. Corner Bridge Floor S.W. 18.30'

N.E. Corner Bridge Floor S.E. 19.27'

⊕ M-45 Pavement N 91.00'

Nail in Face of 18" Poplar E 21.84'

Nail in Face of Guy Pole N.E. 82.14'

0200  
# 2000  

