

**SURVEY &
REMONUMENTATION**

APR 25 1995

OTTAWA COUNTY REMONUMENTATION
LAND CORNER RECORDATION CERTIFICATE
Filing Requirement of Act 74, Mich. P.A. 1970

RECORDED

94 DEC -8 PM 12:36

for corners in **COMMISSION**

D. J. ...
REGISTER OF DEEDS
OTTAWA COUNTY, MI

<u>Ottawa</u> <small>(County)</small>	Located In: <u>Robinson Twp</u>	Corner Code # <u>C-13</u>
Public Land Survey	T <u>7N</u> R <u>15W</u>	<u>SW corner</u>
	T _____ R _____	<u>Section 32</u>
	T _____ R _____	
	T _____ R _____	
Property Controlling in Section	S _____ T _____ R _____	
Miscellaneous Property in Sec.	S _____ T _____ R _____	

Register of Deeds Stamp & File Number

Lot No. _____, Recorded Plat _____
Private Claims _____

	A	B	C	D	E	F	G	H	I	J	K	L	M
2	6	5	4	3	2	1							
3													
4	7	8	9	10	11	12							
5													
6	18	17	16	15	14	13							
7													
8	19	20	21	22	23	24							
9													
10	30	29	28	27	26	25							
11													
12	31	32	33	34	35	36							
13													

Carl P. Englert, in a field survey on March 18, 1994,
do hereby certify that under requirements of P.A. 74, Michigan P.A. of 1970, the corner points mentioned
in lines 1 and 2 above were in conformance with regulations and rules therefore as required in the
current manual of survey instructions of the United States Department of the Interior, Bureau of Land
Management or by a decree of a Court of Law and/or that the corner points mentioned in lines 3, 4 and 5
above were in conformance with the rules of the Michigan Board of Land Surveyors or by a Decree of a
Court of Law; established, re-established, monumented, re-monumented, recovered, found as
expressed below:

**NOTE: Not more than 4 corners, all in the same town and range, may be recorded
on this certificate.**

Description of original monument and accessories and/or subsequent restoration:
C-13 corner common to Sections 31 and 32.
Original gov't corner set May 1832
by Calvin Britain D.S.
Set Corner
Tamarack 12" N31°W 16 links
Do 7" N55°E 35 links

LCRC Liber 6, Page 75
Found CIM
West 199.44 to Olive Corner
NNE 92.59 Nail in W. side 18" Oak
NE 58.03' Nail in S. side 18" Maple


(See Back of Page)

Description of corner evidence found and/or method applied in restoring or reestablishing corner:
C-13 corner common to Section 31 and 32.
Found 3" Harrison Cast Iron Mon. in Mon. Box 1 Foot N. of Pavement
Found West 199.44' Olive Corner
Found N.N.E. 92.59' Nail in W. side 18" Oak
Found NE 58.03' Nail in S. side 18" Maple

Accepted as a careful and faithful perpetuation of the position of
the original corner.

P.A. 345 OTTAWA COUNTY
PEER APPROVED 11/21/94
[Signature]

Description of monument for corner and accessories established to perpetuate locating the position of the corner:
C-13 corner common to Sections 31 and 32.
3" Harrison CIM in Mon. Box
Cross cut in S. End Conc. Culvert S35°E 32.02'
O.C. Remon. Tag & Nail in North side 12" Maple (clump) S52°W 267.69'
O.C. Remon. Tag & Nail in S.E. side 30" Oak N18°E 92.34'
Top center of hydrant N55°E 50.98'
Olive Corner West 199.44'

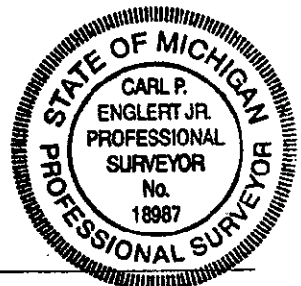

Signed by Carl P. Englert Jr. Date 11/17/94
Surveyor's Michigan License No. 18987

FORM APPROVED BY MICHIGAN STATE BOARD OF LAND SURVEYORS, JAN. 28, 1971
REVISED MAY 14, 1975
REVISED JAN., 1983

A. Description of original monument and accessories and/or subsequent restoration:

C-13 LCRC Liber 2, Page 35
Set CIM
18" Maple E.N.E. 57.90'
18" Oak N.N.E. 91.86'
Centerline Stop Sign N.W. 37.60'
8" Ash S.E. 38.09'
Maple Clump S.W. 35.51'

CODE # 120 M
CORNER 9.00
CODE # 150 M
HSSR 2.00