

**SURVEY &  
REMONUMENTATION**

APR 24 1995

**COMMISSION**

OTTAWA COUNTY REMONUMENTATION  
**LAND CORNER RECORDATION CERTIFICATE**  
Filing Requirement of Act 74, Mich. P.A. 1970

RECORDED

94 DEC 15 AM 11:52

*Polysthenie Balthazard*  
REGISTER OF DEEDS  
OTTAWA COUNTY, MI

For corners in

Ottawa (County)	Located In: Robinson Twp.	Corner Code #
1. Public Land Survey	T <u>7</u> N R <u>15</u> W	D-5
	T ___ R ___	N $\frac{1}{4}$ Corner
	T ___ R ___	Section 17
	T ___ R ___	
2. Property Controlling in Section	S ___ T ___ R ___	
	S ___ T ___ R ___	
3. Miscellaneous Property in Sec.	S ___ T ___ R ___	
	S ___ T ___ R ___	

Register of Deeds Stamp & File Number

4. Lot No. \_\_\_\_\_, Recorded Plat \_\_\_\_\_  
5. Private Claims \_\_\_\_\_

	A	B	C	D	E	F	G	H	I	J	K	L	M
2	6	5	4	3	2	1							
3													
4	7	8	9	10	11	12							
5													
6	18	17	16	15	14	13							
7													
8	19	20	21	22	23	24							
9													
10	30	29	28	27	26	25							
11													
12	31	32	33	34	35	36							
13													

I, Carl P. Englert, in a field survey on December 01, 19 94, do hereby certify that under requirements of P.A. 74, Michigan P.A. of 1970, the corner points mentioned in lines 1 and 2 above were in conformance with regulations and rules therefore as required in the current manual of survey instructions of the United States Department of the Interior, Bureau of Land Management or by a decree of a Court of Law and/or that the corner points mentioned in lines 3, 4 and 5 above were in conformance with the rules of the Michigan Board of Land Surveyors or by a Decree of a Court of Law; established, re-established, monumented, re-monumented, recovered, found as expressed below:

**NOTE: Not more than 4 corners, all in the same town and range, may be recorded on this certificate.**

A. Description of original monument and accessories and/or subsequent restoration:

D-5 1/4 corner common to Sections 8 & 17

Original Gov't corner set May, 1832

by Calvin Britain D.S.

LCRC Liber 5, Page 371 (6/21/89)

D-5

Set CIM

Set Post  
Black Ash 10" N78°E 27 Links  
Black Ash 8" S40°W 16 Links

Nail in W Face 12" Poplar N 35.98  
Nail in SW face 24" W. Pine NW 65.66  
Nail in W Face 8" Poplar S 22.54  
Set Pk in SW face SE 77.24

(See Back of Sheet)

B. Description of corner evidence found and/or method applied in restoring or reestablishing corner:

D-5 1/4 corner common to Sections 8 & 17

Found 4" Harrison CIM in surface asphalt pavement 7'+/- S. of Road E  
Found Nail in SW face 24" W. Pine N.W. 65.66'  
Found Poplar Stump North 36'+/-

Accepted as a careful and faithful perpetuation of the original position of the corner

P.A. 345 OTTAWA COUNTY


PEER APPROVED 12/12/94

C. Description of monument for corner and accessories established to perpetuate locating the position of the corner:

D-5 1/4 corner common to Sections 8 & 17

4" Harrison Cast Iron Mon. in Asphalt Pavement  
O.C. Remon. Tag & Nail in E. side 25" Maple N 5°E 86.73'  
O.C. Remon. Tag & Nail in S.W. side 13" Larch S58°E 67.40'  
O.C. Remon. Tag & Nail in N. side Tel. P. S71°W 57.35'  
O.C. Remon. Tag & Nail in S.W. side 24" W Pine N60°W 65.59'

Signed by Carl P. Englert Jr. Date 12/5/94  
Surveyor's Michigan License No. 18987

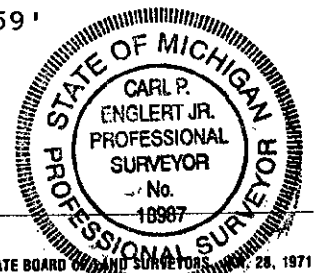

FORM APPROVED BY MICHIGAN STATE BOARD OF SURVEYORS AND SURVEYORS, 28, 1971  
REVISED MAY 14, 1976  
REVISED JAN., 1983

LCRC Liber 1, Page 341, 4/21/72

D-5

Found Steel Bar

Nail in Face of 30" Pine	NW
Nail in Face of Tel. Pole	NE
Nail in Face of 10" Birch	SE
Nail in Face of 15" Ash	SE

1972  
# 1000  

