

SURVEY & REMONUMENTATION

APR 24 1995

OTTAWA COUNTY REMONUMENTATION LAND CORNER RECORDATION CERTIFICATE Filing Requirement of Act 74, Mich. P.A. 1970

RECORDED

94 DEC 15 AM 11:49

For corner **COMMISSION**

Edythe C. Williams
REGISTER OF DEEDS
OTTAWA COUNTY, MI

<u>Ottawa</u> (County)	Located In: Robinson Twp.	Corner Code -#
1. Public Land Survey	T <u>7N</u> R <u>15W</u>	<u>D-11</u>
	T _____ R _____	<u>N 1/4 corner</u>
	T _____ R _____	<u>Section 32</u>
	T _____ R _____	_____
2. Property Controlling in Section	S _____ T _____ R _____	_____
	S _____ T _____ R _____	_____
3. Miscellaneous Property in Sec.	S _____ T _____ R _____	_____
	S _____ T _____ R _____	_____
4. Lot No. _____, Recorded Plat _____		
5. Private Claims _____		

Register of Deeds Stamp & File Number

I, Carl P. Englert in a field survey on December 02, 19 94, do hereby certify that under requirements of P.A. 74, Michigan P.A. of 1970, the corner points mentioned in lines 1 and 2 above were in conformance with regulations and rules therefore as required in the current manual of survey instructions of the United States Department of the Interior, Bureau of Land Management or by a decree of a Court of Law and/or that the corner points mentioned in lines 3, 4 and 5 above were in conformance with the rules of the Michigan Board of Land Surveyors or by a Decree of a Court of Law; established, re-established, monumented, re-monumented, recovered, found as expressed below:

NOTE: Not more than 4 corners, all in the same town and range, may be recorded on this certificate.

A	B	C	D	E	F	G	H	I	J	K	L	M
2	6	5	4	3	2	1						
3												
4	7	8	9	10	11	12						
5												
6	18	17	16	15	14	13						
7												
8	19	20	21	22	23	24						
9												
10	30	29	28	27	26	25						
11												
12	31	32	33	34	35	36						
13												

A. Description of original monument and accessories and/or subsequent restoration:

D-11 1/4 corner common to Sections 29 & 32
Original Gov't corner set May, 1832
by Calvin Britain D.S.

LCRC Liber 2, Page 35 (1/23/73)
D-11 Set Cast Iron Mon. in Place of
Angle Iron
8" Cherry WSW 33.58'
8" Poplar SE 20.67'
Gravel Rd. EAST 28.'
Conc. Mon. EAST 48.'
6" Poplar NW 15.55'
Angle Iron WEST 33.'

Tamarack 8" is post

B. Description of corner evidence found and/or method applied in restoring or reestablishing corner:

D-11 1/4 corner common to Sections 29 & 32

Found 4" Harrison CIM (broken top) 1'+/- deep on N. bank of Ditch
Found Gravel Rd. 28'+/- EAST

PEER APPROVED 12/12/94
Wesley D. Nelson

Accepted as a careful and faithful perpetuation of the original position of the corner.

C. Description of monument for corner and accessories established to perpetuate locating the position of the corner:


D-11 1/4 corner common to Sections 29 & 32

4" Harrison Cast Iron Monument 28'+/- West of Road Gravel
O.C. Remon. Tag & Nail in S.W. side 8" Cherry
O.C. Remon. Tag & Nail in E. side 18" Pine
O.C. Remon. Tag & Nail in N.W. side 7" Aspen
O.C. Remon. Tag & Nail in S. side 7" Cherry
1/2" Iron bar in Road

N37°W 38.75'
N05°W 157.57'
N39°E 89.80'
N77°E 71.00'
EAST 33.1'

Signed by Carl P. Englert Jr.
Surveyor's Michigan License No. 18987

Date 12/12/94

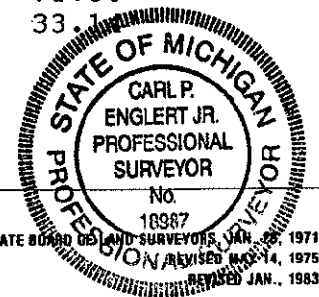

FORM APPROVED BY MICHIGAN STATE BOARD OF LAND SURVEYORS, JAN. 28, 1971
REVISED MAR. 14, 1975
REVISED JAN., 1983