

**SURVEY &
REMONUMENTATION**

FEB 27 1998

SECTION

OTTAWA COUNTY REMONUMENTATION
LAND CORNER RECORDATION CERTIFICATE
Filing Requirement of Act 74, Mich. P.A. 1970

RECORDED

97 OCT 30 AM 11:00

For corners in

<u>Ottawa</u> (County)	Located In: Robinson Township	Corner Code # <u>E-2</u>
1. Public Land Survey	T <u>7N</u> R <u>R15W</u>	<u>West 1/4</u> corner
	T ___ R ___	<u>Section 4</u>
	T ___ R ___	_____
	T ___ R ___	_____
2. Property Controlling in Section	S ___ T ___ R ___	_____
	S ___ T ___ R ___	_____
3. Miscellaneous Property in Sec.	S ___ T ___ R ___	_____
	S ___ T ___ R ___	_____

Debra Gant

Register of Deeds
Ottawa County, MI

Register of Deeds Stamp & File Number

4. Lot No. _____, Recorded Plat _____
5. Private Claims _____

I, Carl P. Englert, in a field survey on 2/27, 1997 do hereby state that under requirements of P.A. 74, Michigan P.A. of 1970, the corner points mentioned in lines 1 and 2 above were in conformance with regulations and rules therefore as required in the current manual of survey instructions of the United States Department of the Interior, Bureau of Land Management or by a decree of a Court of Law and /or that the corner points mentioned in lines 3, 4 and 5 above were in conformance with the rules of the Michigan Board of Land Surveyors or by a Decree of a Court of Law, established, re-established, monumented, recovered, found as expressed below:

NOTE: Not more than 2 corners, all in the same town and range, may be recorded on this certificate.

	A	B	C	D	E	F	G	H	I	J	K	L	M
1													
2	6		5		4		3		2		1		
3													
4	7		8		9		10		11		12		
5													
6	18		17		16		15		14		13		
7													
8	19		20		21		22		23		24		
9													
10	30		29		28		27		26		25		
11													
12	31		32		33		34		35		36		
13													

A. Description of original monument and accessories and/or subsequent restoration:

E-2 1/4 corner common to Sections 4 and 5
G.L.O. 1832 Calvin Britain
Set 1/2 Mile Post
W. Ash 6" S30°E 46 links
Pine 20" N 2°E 3.75 chains

E-2 Liber 1, Page 255
Found Steel Rod 1-25-72
Nail in face of 8" Red Pine SE 61.34'
Nail in face of Tele Pole SE 58.16'
Nail in face of Power Pole SW 63.89'
Nail in face of 8" Twin Oak W 76.69'
Nail in face of Tele Pole NE 72.70'
St. Sign NW 32.40'

See Other Side

B. Description of corner evidence found and/or method applied in restoring or reestablishing corner:

E-2 1/4 corner common to Sections 4 and 5
Found 4" Harrison Cast Iron Monument in Mon. Box in Rd. Q N, S & E
Found P.P. SW 65.13'
Found 12" Twin Oak West 77' (Stump)

P.A. 345 OTTAWA COUNTY
PEER APPROVED 9-15-97

[Signature]


Accepted as a careful and faithful perpetuation of the original position of the corner.

C. Description of monument for corner and accessories established to perpetuate locating the position of the corner:

E-2 1/4 corner common to Section 4 and 5
4" Harrison Cast Iron Monument in Monument Box
O.C. Remon Tag & Nail in West Side 12" Pine S19°E 108.69'
O.C. Remon Tag & Nail in NW Side Power Pole S58°W 65.10'
O.C. Remon Tag & Nail in S Side 12" Twin Oak West 82.25'
O.C. Remon Tag & Nail in E Side Power Pole N13°W 267.83'

Signed by Carl P. Englert Jr
Surveyor's Michigan License No. 18987

Date 9/15/1997

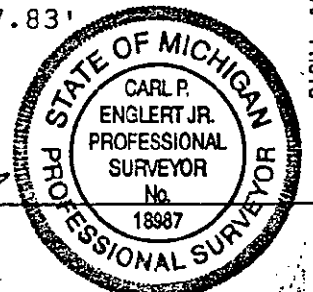

\$ 11.00 CORNER
\$ 2.00 PHOTO

Robinson Township Section 4, Town 7 North, Range 15 West
E-2 Liber 4, Page 276 (7-10-81)
Found Steel Bar in Mon. Box
10" Pine ESE 68.50'
10" Pine SE 61.36'
Power Pole SW 65.14'
9" Twin Oak W 77.02'

Robinson Township Section 4, Town 7 North, Range 15 West
E-2 Liber 5, Page 106 (6-27-84)
Found Iron Bar
Set Cast Iron Monument
Twin 4" Oak W 59.75'
Power Pole SW 65.13'
12" Pine SE 72.72'
10" Pine ESE 68.50'

**SURVEY &
REMONUMENTATION**

FEB 27 1998

SECTION