

SURVEY & REMONUMENTATION

APR 25 1995

COMMISSION

OTTAWA COUNTY REMONUMENTATION
LAND CORNER RECORDATION CERTIFICATE
Filing Requirement of Act 74, Mich. P.A. 1970

RECORDED

DEC - 8 PM 12:35

D. J. ...
REGISTER OF DEEDS
OTTAWA COUNTY, MI

For corners in

<u>Ottawa</u> (County)	Located In: Robinson Twp.	Corner Code # E-12
Public Land Survey	T <u>7N</u> R <u>15W</u>	<u>E 1/4</u> Corner
	T _____ R _____	Section 32
	T _____ R _____	
Property Controlling in Section	S _____ T _____ R _____	
Miscellaneous Property in Sec.	S _____ T _____ R _____	

Register of Deeds Stamp & File Number

1. Lot No. _____, Recorded Plat _____
2. Private Claims _____

	A	B	C	D	E	F	G	H	I	J	K	L	M
2	6		5		4		3		2				
3													
4	7		8		9		10		11		12		
5													
6	18		17		16		15		14		13		
7													
8	19		20		21		22		23		24		
9													
10	30		29		28		27		26		25		
11													
12	31		32		33		34		35		36		
13													

Carl P. Englert in a field survey on November 18, 19 94
do hereby certify that under requirements of P.A. 74, Michigan P.A. of 1970, the corner points mentioned in lines 1 and 2 above were in conformance with regulations and rules therefore as required in the current manual of survey instructions of the United States Department of the Interior, Bureau of Land Management or by a decree of a Court of Law and/or that the corner points mentioned in lines 3, 4 and 5 above were in conformance with the rules of the Michigan Board of Land Surveyors or by a Decree of a Court of Law; established, re-established, monumented, re-monumented, recovered, found as expressed below:

NOTE: Not more than 4 corners, all in the same town and range, may be recorded on this certificate.

1. Description of original monument and accessories and/or subsequent restoration:
E-12 1/4 corner common to Sections 32 & 33
Original Gov't corner set May 1832 by Calvin Britain
Liber 2, Page 35
Set Cast Iron Mon. in Place of Iron
2" Apple N.E. 45.10'
8" Pine S.E. 54.55'
P.P. SW 44.64'
14" Cherry N.W. 66.88'
Centerline CMP North 10.50'

2. Description of corner evidence found and/or method applied in restoring or reestablishing corner:
E-12 1/4 corner common to Sections 32 & 33
Found 4" Harrison Cast Iron Mon. 3'+/- W. of Road Centerline 3" Deep
Found 8" Pine S.E. 54.55'
Found P.P. S.W. 44.64'
Found CMP Culvert N. 10' +/-


P.A. 345 OTTAWA COUNTY
PEER APPROVED 11/21/94
Andy P. ...

Accepted as a careful and faithful perpetuation of the original position of the corner.

3. Description of monument for corner and accessories established to perpetuate locating the position of the corner:
E-12 1/4 corner common to Sections 32 & 33
4" Harrison Cast Iron Mon.
O.C. Remon. Tag & Nail in S.W. Side 13" Pine S48°E 54.84'
O.C. Remon. Tag & Nail in N.W. Side P.P. S68°W 44.94'
O.C. Remon. Tag & Nail in E. Side 15" Pine N30°W 134.13'
O.C. Remon. Tag & Nail in N.W. side N.W. Pole, Pole Bldg. N49°W 107.59'

Signed by Carl P. Englert Jr.
Surveyor's Michigan License No. 18987

Date 11/21/94

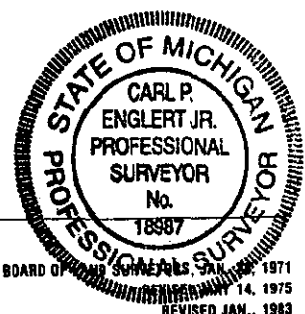

FORM APPROVED BY MICHIGAN STATE BOARD OF SURVEYORS, JAN. 14, 1975
REVISED JAN., 1983