

Ottawa County Remonumentation

RECORDED

93 DEC 15 AM 9:29

LAND CORNER RECORDATION CERTIFICATE
Filing Requirement of Act 74, Mich. P.A. 1970

For corners in

Ottawa
(County)

Located In: Robinson Township
Corner Code #

- 1. Public Land Survey T 7N R 15W E-5
T ___ R ___ North 1/2 Cor.
T ___ R ___ Section 16
T ___ R ___
- 2. Property Controlling S ___ T ___ R ___
in Section S ___ T ___ R ___
- 3. Miscellaneous S ___ T ___ R ___
Property in Sec. S ___ T ___ R ___

Elizabeth Robinson
REGISTER OF DEEDS
OTTAWA COUNTY, MI

Register of Deeds Stamp & File Number

- 4. Lot No. _____, Recorded Plat _____
- 5. Private Claims _____

A	B	C	D	E	F	G	H	I	J	K	L	M
2	6	5	4	3	2	1						
3												
4	7	8	9	10	11	12						
5												
6	18	17	16	15	14	13						
7												
8	19	20	21	22	23	24						
9												
10	30	29	28	27	26	25						
11												
12	31	32	33	34	35	36						
13												

Carl P. Englert Jr.

I, _____, in a field survey on November 10, 1993, do hereby certify that under requirements of P.A. 74, Michigan P.A. of 1970, the corner points mentioned in lines 1 and 2 above were in conformance with regulations and rules therefore as required in the current manual of survey instructions of the United States Department of the Interior, Bureau of Land Management or by a decree of a Court of Law and/or that the corner points mentioned in lines 3, 4 and 5 above were in conformance with the rules of the Michigan Board of Land Surveyors or by a Decree of a Court of Law; established, re-established, monumented, re-monumented, recovered, found as expressed below:

NOTE: Not more than 4 corners, all in the same town and range, may be recorded on this certificate.

A. Description of original monument and accessories and/or subsequent restoration:

F-5 L.C.R.C. Liber 1, Page, 5/11/72
Fd. 1" Pipe
Nail in face of P.P. SW 65.83'
Nail in face of 15" Cherry NE 43.80'
Nail in face of P.P. NE 102.40'
Nail in face of 10" Maple WNW 94.74'
Nail in face of P.P. NW 132.35'
C/L St. Sign NNE 26.63'

L.C.R.C. No Liber & Page, 3/15/89
Fd. Iron Pipe, Set C.I.M.
Nail in SE face 24" Oak NE 44.75'
Nail in W face 14" Oak N 47.15'
Nail in S face 14" Maple NW 95.11'
P.K. Nail in NW face Ut.P. SW 66.43'

B. Description of corner evidence found and/or method applied in restoring or reestablishing corner:

F-5
Found 3" Harrison in Mon. Box
and accepted as a careful and
faithful perpetuation of the
position of the original corner.


Fd. Nail in W side 14" Oak N 47.15'
Nail in S face 14" Maple 95.11'
P.P. NW 132.3+

C. Description of monument for corner and accessories established to perpetuate locating the position of the corner:

F-5 3" Harrison Cast Iron Monument in Mon. Box
O.C. Remon. Tag & Nail in NW side 6" White Pine N 37 degrees E 66.90'
O.C. Remon. Tag & Nail in W side 15" Oak N 10 degrees 47.06'
O.C. Remon. Tag & Nail in NW side 22" Oak N 30 degrees 87.77'
O.C. Remon. Tag & Nail in SW side P.P. N 77 degrees W 132.60'
O.C. Remon. Tag & Nail in SE side P.P. S 42 degrees w 64.70'
(E.D.M.)

Signed by Carl P. Englert Jr.
Surveyor's Michigan License No. 18987

Date December 3, 1993

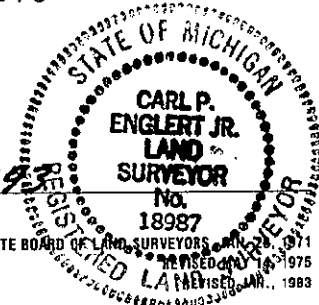

FORM APPROVED BY MICHIGAN STATE BOARD OF LAND SURVEYORS
REVISED APR. 1975
REVISED MAR., 1983