

**SURVEY &
REMONUMENTATION**

FEB 27 1998

SECTION

**OTTAWA COUNTY REMONUMENTATION
LAND CORNER RECORDATION CERTIFICATE
Filing Requirement of Act 74, Mich. P.A. 1970**

RECORDED

97 OCT 30 AM 11:00

For corners in

Ottawa	Located In:	Corner Code #
(County)	Robinson	
	Township	
1. Public Land Survey	T <u>7</u> N R <u>15</u> W	F-13
	T <u> </u> R <u> </u>	South 1/4
	T <u> </u> R <u> </u>	Cor. Sec. 33
	T <u> </u> R <u> </u>	
2. Property Controlling In Section	S <u> </u> T <u> </u> R <u> </u>	
	S <u> </u> T <u> </u> R <u> </u>	
3. Miscellaneous Property in Sec.	S <u> </u> T <u> </u> R <u> </u>	
	S <u> </u> T <u> </u> R <u> </u>	

Debra Gant

Register of Deeds
Ottawa County, MI

Register of Deeds Stamp & File Number

4. Lot No. _____, Recorded Plat _____
5. Private Claims _____

I, Carl P. Englert, in a field survey on 3/3, 1997 do hereby state that under requirements of P.A. 74, Michigan P.A. of 1970, the corner points mentioned in lines 1 and 2 above were in conformance with regulations and rules therefore as required in the current manual of survey instructions of the United States Department of the Interior, Bureau of Land Management or by a decree of a Court of Law and /or that the corner points mentioned in lines 3, 4 and 5 above were in conformance with the rules of the Michigan Board of Land Surveyors or by a Decree of a Court of Law; established, re-established, monumented, recovered, found as expressed below:

1	A	B	C	D	E	F	G	H	I	J	K	L	M
2		6		5		4		3		2		1	
3													
4		7		8		9		10		11		12	
5													
6		10		17		16		15		14		13	
7													
8		19		20		21		22		23		24	
9													
10		30		29		28		27		26		25	
11													
12		31		32		33		34		35		36	
13													

NOTE: Not more than 2 corners, all in the same town and range, may be recorded on this certificate.

A. Description of original monument and accessories and/or subsequent restoration:

F-13 South 1/4 corner Section 33	LCRC Liber 5, Page 55 5/17/83
G.L.O. Sylvester Sibley 1831	Found 3/4" Iron Bar, Set Cast Iron
Set 1/2 mile post	Monument
Hemlock 8" N32°E 17 links	6" Pine NNE 37.81'
Hemlock 10" N44°W 18 links	10" Wh. Pine SE 29.78'
	10" Red Pine SW 59.55'
	Olive Twp. Cor. W. 66.50'

See Other Side

B. Description of corner evidence found and/or method applied in restoring or reestablishing corner:

F-13 South 1/4 corner Section 33
 Found 4" Harrison Cast Iron Monument in Monument Box in Q B.T. Road
 Found 20" Wh. Pine SE 29.8± (No Nail) P.A. 345 OTTAWA COUNTY
 Found 14" Red Pine SW 59.5± (No Nail)
 Found 6" Pine NNE 37.8± (No Nail) PEER APPROVED 9-15-97
 Found Olive Twp. corner West 66.55'

Accepted as a careful and faithful perpetuation of the position of the original corner.


C. Description of monument for corner and accessories established to perpetuate locating the position of the corner:

F-13 South 1/4 corner Section 33
 4" Harrison Cast Iron Monument 6" deep in Monument Box
 O.C. Remon Tag & Nail in SW side 30" White Pine N40°W 105.19'
 O.C. Remon Tag & Nail in NW side 8" Scotch Pine N32°E 47.36'
 O.C. Remon Tag & Nail in NE side 20" White Pine S33°E 29.71'
 O.C. Remon Tag & Nail in NW side 12" Red Pine S42°W 59.36'
 West 66.55' to North 1/4 corner of Section 4, Town 6 North, Range 15 West

\$ 11.00 CORNER
\$ 2.00 PHOTO

Signed by Carl P. Englert
 Surveyor's Michigan License No. 18987

Date 9/15/1997

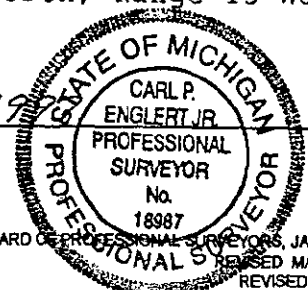

F-13, Town 7 North, Range 15 West
LCRC Liber 6, Page 144 6/11/1991
Found Cast Iron Monument, Raised Same
14" White Pine SE 29.90'
14" Red Pine SW 59.54'
8" Red Pine NE 47.37'
Olive Twp. corner W. 66.55'

**SURVEY &
REMONUMENTATION**

FEB 27 1998

SECTION