

**SURVEY & REMONUMENTATION**

JUN 28 1999

**OTTAWA COUNTY REMONUMENTATION  
LAND CORNER RECORDATION CERTIFICATE  
Filing Requirement of Act 74, Mich. P.A. 1970**

**RECORDED**  
98 NOV 11 PM 1:26

*Greg Sublett*  
REGISTER OF DEEDS  
OTTAWA COUNTY, MI

**SECTION**

For corners in	Robinson Twp.	
<u>Ottawa</u>	Located In:	Corner Code #
(County)		
1. Public Land Survey	T <u>7N</u> R <u>15W</u>	<u>G-1</u>
	T ___ R ___	<u>NW corner</u>
	T ___ R ___	<u>Section 3</u>
	T ___ R ___	_____
2. Property Controlling in Section	S ___ T ___ R ___	_____
	S ___ T ___ R ___	_____
3. Miscellaneous Property in Sec.	S ___ T ___ R ___	_____
	S ___ T ___ R ___	_____

Register of Deeds Stamp & File Number

4. Lot No. \_\_\_\_\_, Recorded Plat \_\_\_\_\_  
5. Private Claims \_\_\_\_\_

	A	B	C	D	E	F	G	H	I	J	K	L	M
1							5						
2	6		5		4			3		2			1
3													
4	7		8		9			10		11			12
5													
6	18		17		16			15		14			13
7													
8	19		20		21			22		23			24
9													
10	30		29		28			27		26			25
11													
12	31		32		33			34		35			36
13													

I, Carl P. Englert, Jr., in a field survey on 10/16, 19 98 do hereby state that under requirements of P.A. 74, Michigan P.A. of 1970, the corner points mentioned in lines 1 and 2 above were in conformance with regulations and rules therefore as required in the current manual of survey instructions of the United States Department of the Interior, Bureau of Land Management or by a decree of a Court of Law and/or that the corner points mentioned in lines 3, 4 and 5 above were in conformance with the rules of the Michigan Board of Land Surveyors or by a Decree of a Court of Law; established, re-established, monumented, recovered, found as expressed below:

NOTE: Not more than 2 corners, all in the same town and range, may be recorded on this certificate.

A. Description of original monument and accessories and/or subsequent restoration:

- G-1 Corner common to Sections 3 and 4, T7N, R15W
- G.L.O. 1832 by Noah Brookfield
- North Boundary 20 Links E of Post Set Corner to Sections 3 and 4
- Black Ash 10" S 17° E 44 Links
- Hemlock 8" S 85° W 45 Links
- E.H. Peck March 1899 Found Stake
- Elm 18" N 46° W 77'
- Pine 8" N 12½° W 73'

B. Description of corner evidence found and/or method applied in restoring or reestablishing corner:


- G-2 Found 4" Cast Iron Monument in Mon. Box 4' East of E Asphalt Rd.
- Found SW Corner Section 34, T8N, R15W, West 13.40'
- I replaced an Iron Pipe with the Cast Iron Monument some time around 1985. It apparently was never recorded.

Accepted as a careful and faithful perpetuation of the original position of the corner.

RECORDED 10/19/98

C. Description of monument for corner and accessories established to perpetuate locating the position of the corner:

- G-3 Corner common to Sections 3 and 4, T7N, R15W
- 4" Harrison Cast Iron Monument in Mon. Box 0.29' South of Town line
- O.C. Remon Tag & Nail in S. Side 14" Oak N 80° E 47.97'
- O.C. Remon Tag & Nail in NW. Side 7" Aspen N 35° E 55.30'
- O.C. Remon Tag & Nail in SW. Side 8" Willow S 60° E 34.36'
- O.C. Remon Tag & Nail in E. Side 12" Willow S 20° W 98.00'
- SW Corner Section 34, T8N, R15W. West 13.40'

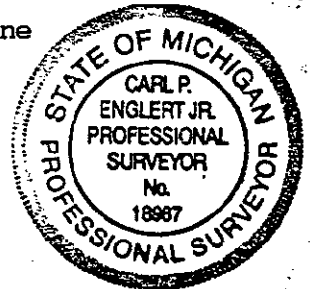

\$11.00 CORNER  
Receipt #19293

\$2.00 PHOTO  
Receipt #19293

Signed by Carl P. Englert Jr.  
Surveyor's Michigan License No. 18987

Date 10/17/1998

SURVEY &  
REMONUMENTATION

JUN 28 1999

SECTION

