

SURVEY & REMONUMENTATION

FEB 27 1998

SECTION

**OTTAWA COUNTY REMONUMENTATION
LAND CORNER RECORDATION CERTIFICATE**
Filing Requirement of Act 74, Mich. P.A. 1970

RECORDED

97 OCT 30 AM 11:00

For corners in

Ottawa
(County)

Located in:
Robinson
Township

Corner Code #

1. Public Land Survey

T7N R15W

G-2

T ___ R ___

West 1/4 corner
Section 3

T ___ R ___

T ___ R ___

2. Property Controlling
in Section

S ___ T ___ R ___

S ___ T ___ R ___

3. Miscellaneous
Property in Sec.

S ___ T ___ R ___

S ___ T ___ R ___

Debra Gant

Register of Deeds
Ottawa County, MI

Register of Deeds Stamp & File Number

4. Lot No. _____, Recorded Plat _____
5. Private Claims _____

	A	B	C	D	E	F	G	H	I	J	K	L	M
1													
2	6		5		4		3		2		1		
3													
4	7		8		9		10		11		12		
5													
6	18		17		16		15		14		13		
7													
8	19		20		21		22		23		24		
9													
10	30		29		28		27		26		25		
11													
12	31		32		33		34		35		36		
13													

I, Carl P. Englert, in a field survey on 2/27, 1997 do hereby state that under requirements of P.A. 74, Michigan P.A. of 1970, the corner points mentioned in lines 1 and 2 above were in conformance with regulations and rules therefore as required in the current manual of survey instructions of the United States Department of the Interior, Bureau of Land Management or by a decree of a Court of Law and for that the corner points mentioned in lines 3, 4 and 5 above were in conformance with the rules of the Michigan Board of Land Surveyors or by a Decree of a Court of Law, established, re-established, monumented, recovered, found as expressed below:

NOTE: Not more than 2 corners, all in the same town and range, may be recorded on this certificate.

A. Description of original monument and accessories and/or subsequent restoration:

- G-2 1/4 corner common to Sections 3 and 4
- G.L.O. 1832 Calvin Britain
- Set 1/2 Mile Post
- Beech 10" S35°W 25 links
- Beech 10" N35°E 15 links
- LCRC Liber 1, Page 49 (6-26-71)
- G-2 Found Iron Bar
- 30" Oak NW 52.37'
- 28" Oak NE 107.16'
- Power Pole NE 108.53'
- Tel. Pole SE 98.85'
- Q Street Sign NE 59.37'

See Other Side

B. Description of corner evidence found and/or method applied in restoring or reestablishing corner:


- G-2 1/4 corner common to Sections 3 and 4
- Found 4" Harrison Cast Iron Monument 1' West of N & S Road Q on Q, E & W Rd.
- Found Tel. Pole SE 98.85'
- Found 30" Oak NW 53.46'
- Found 30" Oak NE 107.16'
- Found St. Sign NE 59.40'

P.A. 345 OTTAWA COUNTY
PEER APPROVED 9-15-97

Accepted as a careful and faithful perpetuation of the original position of the corner.

C. Description of monument for corner and accessories established to perpetuate locating the position of the corner:

- G-2 1/4 corner common to Sections 3 and 4
- 4" Harrison Cast Iron Monument in Monument Box
- O.C. Remon Tag and Nail in S Side Tel. Pole S74°E 98.83'
- O.C. Remon Tag and Nail in SE Side 30" Oak N20°E 107.78'
- O.C. Remon Tag and Nail in NE Side 36" Oak N36°W 53.93'
- O.C. Remon Tag and Nail in S Side Tel. Pole N49°W 52.50'

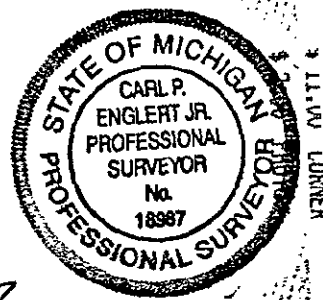

Signed by Carl P. Englert Jr.
Surveyor's Michigan License No. 18987

Date 9/15/1997

Robinson Township
E 1/4 corner Section 4, Town 7 North, Range 15 West (5-29-79)
Liber 3, Page 349
G-2 Found Iron Bolt
NW 30" Oak 52.37'
NE 28" Oak 107.16'
SE Tel. Pole 98.85'

Robinson Township
E 1/4 corner Section 4, Town 7 North, Range 15 West (12-3-81)
Liber 4, Page 252
G-2 Found 1" Iron
Set Cast Iron Monument
Tele. Pole ESE 98.91'
Street Sign NE 59.31'
26" Oak NW 53.46'
Twin 4" Hemlock NW 57.23'

**SURVEY &
REMONUMENTATION**

FEB 27 1998

SECTION