

**SURVEY &
REMONUMENTATION**

APR 05 1996

**OTTAWA COUNTY REMONUMENTATION
LAND CORNER RECORDATION CERTIFICATE**

COMMISSION Filing Requirement of Act 74, Mich. P.A. 1970

For corners in

Robinson Twp

Ottawa
(County)

Located In:

Corner Code #

- | | | |
|------------------------------------|----------------------------|-------------------|
| 1. Public Land Survey | T <u>7</u> N R <u>15</u> W | <u>G - 3</u> |
| | T _____ R _____ | <u>NW Corner</u> |
| | T _____ R _____ | <u>Section 10</u> |
| | T _____ R _____ | _____ |
| 2. Property Controlling in Section | S _____ T _____ R _____ | _____ |
| | S _____ T _____ R _____ | _____ |
| 3. Miscellaneous Property in Sec. | S _____ T _____ R _____ | _____ |
| | S _____ T _____ R _____ | _____ |

RECORDED

95 NOV 29 PM 1:48

Richard R. Callman
REGISTER OF DEEDS
OTTAWA COUNTY, MI

Register of Deeds Stamp & File Number

4. Lot No. _____, Recorded Plat _____
5. Private Claims _____

A	B	C	D	E	F	G	H	I	J	K	L	M
2	6	5	4	3	2	1						
3												
4	7	8	9	10	11	12						
5												
6	18	17	16	15	14	13						
7												
8	19	20	21	22	23	24						
9												
10	30	29	28	27	26	25						
11												
12	31	32	33	34	35	36						
13												

I, Carl P. Englert, Jr., in a field survey on October 16, 19 95, do hereby certify that under requirements of P.A. 74, Michigan P.A. of 1970, the corner points mentioned in lines 1 and 2 above were in conformance with regulations and rules therefore as required in the current manual of survey instructions of the United States Department of the Interior, Bureau of Land Management or by a decree of a Court of Law and/or that the corner points mentioned in lines 3, 4 and 5 above were in conformance with the rules of the Michigan Board of Land Surveyors or by a Decree of a Court of Law; established, re-established, monumented, re-monumented, recovered, found as expressed below:

NOTE: Not more than 4 corners, all in the same town and range, may be recorded on this certificate.

A. Description of original monument and accessories and/or subsequent restoration:

G - 3 Corner Common to Sections 3, 4, 9, & 10	LCRC Liber 1, Page 45
Original Corner Set May 1832 by Calvin Britain	June 26, 1971
Set 1/4 Post on True Line	Fd. 1" Iron Bar
Birch 6" S 12° W 17 Links	24" Oak NW 66.44'
Beech 10" N 40° W 24 Links	18" Oak SW 55.86'
	8" Oak SW 57.67'
	P.P. NE 50.76'
	CL St. Sign SE 47.38'

see other side

B. Description of corner evidence found and/or method applied in restoring or reestablishing corner:

G - 3 Corner Common to Sections 3, 4, 9, & 10
 Found 4" CIM in Mon Box 2.5'± W of CL Asphalt Road
 Found 20" Oak SW 56.54'
 Found 15" Oak SW 57.67'
 Found 26" Oak NW 67.37'
 Found P.P. NE 51.12'

P.A. 345 OTTAWA COUNTY

PEER APPROVED 11-20-95

Richard P. Redwood
RDW


Accepted as a careful and faithful perpetuation of the position of the original corner.

C. Description of monument for corner and accessories established to perpetuate locating the position of the corner:

G - 3 Corner common to Sections 3, 4, 9, & 10
 4" CIM in Mon Box
 Ottawa County Remonumentation Nail and Tag in W. Side 26" Oak N 40° W 67.11'
 Ottawa County Remonumentation Nail and Tag in NW Side P.P. N 53° E 51.09'
 Ottawa County Remonumentation Nail and Tag in NE Side P.P. S 58° E 128.28'
 Ottawa County Remonumentation Nail and Tag in N. Side 20" Oak S 53° W 56.51'

Signed by Carl P. Englert Jr.
 Surveyor's Michigan License No. 18987

Date 10/18/1995

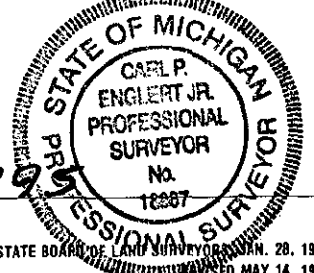

FORM APPROVED BY MICHIGAN STATE BOARD OF LAND SURVEYORS, JAN. 28, 1971
 REVISED MAY 14, 1972
 REVISED JAN., 1982

Robinson Township T. 7 N. R. 15 W.

G-3 Liber 1, Page 629 September 18, 1972

Fd. 3/4" Rod
NE 50.83 P.P.
SE 47.5 St. Sign
SW 57.68' 12" Oak
NW 66.43' 18" Oak

G-3 LCRC Liber 3, Page 349 June, 29, 1979.

Fd Iron Bar
NW 24" Oak 66.44'
SW 18" Oak 55.86'
SE St. Sign 47.38'

G-3 LCRC Liber 4, Page 156 March 22, 1981.

Fd. 1" Solid Iron
Sq. Spike in NW side 18" Oak SW 56.59'
Sq. Spike in NE side 26" Oak NW 67.41'
P.K. in NW side P.P. NE 51.11'

G-3 LCRC Liber 4, Page 252 December 3, 1981.

Fd. 3/4" Iron Set CIM
16" Oak SW 56.54'
11" Oak SW 57.67'
22" Oak NW 67.37'
P.P. NE 51.12"

\$ 11.00 CORNER