

FEB 24 2000

OTTAWA COUNTY REMONUMENTATION PROGRAM
LAND CORNER RECORDATION CERTIFICATE
Filing Requirement of Act 74, Mich. P.A. 1970

RECORDED

99 DEC -2 PM 1:13

SECTION

Ray [Signature]
REGISTER OF DEEDS
OTTAWA COUNTY, MI

For corners in

OTTAWA
(County)

Located in: ROBINSON
(Township)

Corner Code #G-9

- 1. Public Land Survey T 7N R 15W G-9
 T _____ R _____ N.W. Corner
 T _____ R _____ Section 27
 T _____ R _____ _____
- 2. Property Controlling S _____ T _____ R _____
 in Section S _____ T _____ R _____
- 3. Miscellaneous S _____ T _____ R _____
 Property in Sec. S _____ T _____ R _____

Register of Deeds Stamp & File Number

- 4. Lot No. _____, Recorded Plat _____
- 5. Private Claims _____

	A	B	C	D	E	F	G	H	I	J	K	L	M
1													
2	6		5		4		3		2		1		
3													
4	7		8		9		10		11		12		
5													
6	10		17		16		15		14		13		
7													
8	19		20		21		22		23		24		
9													
10	30		29		28		27		26		25		
11													
12	31		32		33		34		35		36		
13													

I, Robert E. Lemke, surveyor, in a field survey on September 9, 1999 do hereby state that under requirements of P.A. 74, Michigan P.A. of 1970, the corner points mentioned in lines 1 and 2 above were in conformance with regulations and rules therefore as required in the current manual of survey instructions of the United States Department of the Interior, Bureau of Land Management or by a decree of a Court of Law and /or that the corner points mentioned in lines 3, 4 and 5 above were in conformance with the rules of the Michigan Board of Land Surveyors or by a Decree of a Court of Law; established, reestablished, monumented, recovered, found as expressed below:

NOTE: Not more than 2 corners, all in the same town and range, may be recorded on this certificate.

A. Description of original monument and accessories and/or subsequent restoration:

SEE BACK OF SHEET FOR CORNER HISTORY

11/15/99
[Signature]

B. Description of corner evidence found and/or method applied in restoring or reestablishing corner:

G-9
FOUND CAST IRON MONUMENT IN MONUMENT BOX 4" BELOW THE TOP OF THE MONUMENT BOX. THE MONUMENT IS IN THE PHYSICAL CENTERLINE OF 120TH AVENUE.

PHYSICAL CENTERLINE OF LAKE MICHIGAN DRIVE
FOUND "+" IN RIVET AT THE CENTER OF THE WEST END OF A 6' X 9' METAL PIPE
CENTER OF A 13" PINE

NORTH 105.3'
N. 50° W. 38.82'
S. 30° W. 59.6'

ACCEPTED AS A CAREFUL AND FAITHFUL PERPETUATION OF THE POSITION OF THE ORIGINAL CORNER.

C. Description of monument for corner and accessories established to perpetuate locating the position of the corner:

G-9
CAST IRON MONUMENT IN MONUMENT BOX 4" BELOW THE TOP OF THE MONUMENT BOX.


PHYSICAL CENTERLINE OF LAKE MICHIGAN DRIVE
FOUND "+" IN RIVET AT THE CENTER OF THE WEST END OF A 6' X 9' METAL PIPE
SET NAIL WITH OTTAWA COUNTY REMON. TAG ON N.W. FACE OF 13" PINE 2.5' ABOVE GROUND
SET "X" 6" ABOVE GROUND ON THE NORTH FACE OF A 3" DIAMETER STEEL POST.
SET NAIL WITH OTTAWA COUNTY REMON. TAG ON THE N.W. FACE OF A WOOD GUY POLE 2.2' ABOVE GROUND.

NORTH 105.3'
N. 50° W. 38.82'
S. 30° W. 59.64'
S. 50° E. 45.87'
N. 30° E. 61.36'

Signed by Robert E. Lemke Date 11-15-1999

For SDI CONSULTANTS, LTD

Surveyor's Michigan License No. 40160

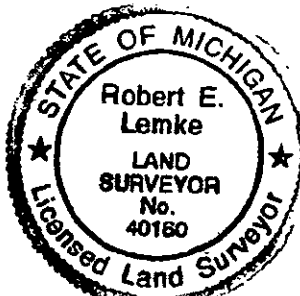

SEE BACK

FORM APPROVED BY MICHIGAN STATE BOARD OF PROFESSIONAL SURVEYORS
JAN. 28, 1971 REVISED MAY 14, 1975
REVISED JAN., 1983
REVISED OCT., 1995

\$11.00 CORNER
Receipt #64965

FEB 24 2000

SECTION

OTTAWA COUNTY
ROBINSON TOWNSHIP
TOWN 7 NORTH, RANGE 15 WEST

G-9

A. Description of original monument and accessories and/or subsequent restoration

-G.L.O.

NORTH BETWEEN SECTIONS 27 & 28
80.0 SET CORNER TO SEC'S 21,22,27 & 28
8" PINE S. 62° E. 21 LINKS
10" PINE N. 84° W. 6.12 LINKS
MAY 1832 (CALVIN BRITAIN)

-OTTAWA COUNTY ROAD COMMISSION NOTES

CEMENT STONE (NO DATE)
N. 33° E. 33' TO FENCE POST

PLACED PIPE 12-29-27 (W. OSNER)
24.7' N.W. TO WING WALL
44' S.E. TO PIECE OF CONCRETE
106.6' SOUTH CENTERLINE PAVEMENT
26.4' N.E. TO WING WALL

FOUND 4-1-60 (G.G)
106.6' SOUTH OF CENTERLINE
24.7' N.W. TO WING WALL
44.0' S.E. TO PIECE OF CONCRETE
42.0' S.W. TO 10" PINE
26.4' N.E. TO WING WALL
38.0' S.E. TO T.P.

-JOHN CLAPP, RECORDED L.C.R.C. LIBER 1 PAGE 587 ON 08-21-1972

SET CAST IRON MONUMENT

NAIL IN FACE OF 14" PINE	SW	52.62'
NAIL IN FACE OF 8" PINE	SW	59.50'
MOST SOUTHERLY COR. SW WINGWALL	NW	24.30'
MOST SOUTHERLY COR. SE WINGWALL	NE	26.24'

-THOMAS JOINER, RECORDED L.C.R.C. LIBER 6 PAGE 58 ON 10-12-1990

SET CIM

8" PINE	SW	59.55
"+" IN NWLY RIVET	WNW	38.81
PK NAIL IN OLD PP	ENE	24.82