1993 Ottawa County Remonumentation

RECORDED

93 DEC 15 AM 9:29

REGISTER OF DEEDS
OTTAWA COUNTY, MI

LAND CORNER RECORDATION CERTIFICATE
Filing Requirement of Act 74, Mich. P.A. 1970

For corners in

Ottawa (County)

Located In: Robinson Township

Corner Code #: G-12 W 1/4 corner Section 34

1. Public Land Survey — T 7N R 15W
2. Property Controlling in Section — S ____ T ____ R ____
3. Miscellaneous Property in Sec. — S ____ T ____ R ____

Register of Deeds Stamp & File Number

4. Lot No. _____, Recorded Plat _____
5. Private Claims _____

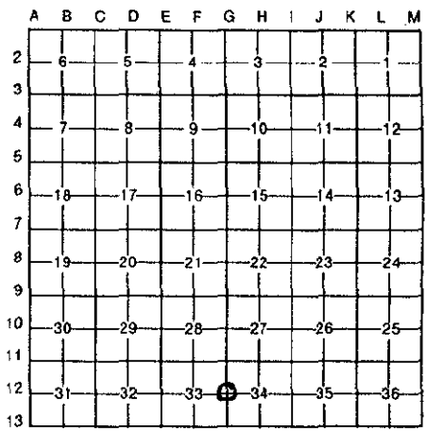

I, Carl P. Englert Jr., in a field survey on November 11, 19 93, do hereby certify that under requirements of P.A. 74, Michigan P.A. of 1970, the corner points mentioned in lines 1 and 2 above were in conformance with regulations and rules therefore as required in the current manual of survey instructions of the United States Department of the Interior, Bureau of Land Management or by a decree of a Court of Law and/or that the corner points mentioned in lines 3, 4 and 5 above were in conformance with the rules of the Michigan Board of Land Surveyors or by a Decree of a Court of Law; established, re-established, monumented, re-monumented, recovered, found as expressed below:

NOTE: Not more than 4 corners, all in the same town and range, may be recorded on this certificate.

A. Description of original monument and accessories and/or subsequent restoration:

G-12
L.C.R.C. Liber 5, Page 94, (12-20-83)
Set C.I.M. on line between Section corners & occupation line East
Centerline of pavement E. 14.5'
P.P. E. 66.09'
10" Pine SE. 88.90'
16" Maple NNW. 92.85'
Tel. Ped. W. 32.86'

B. Description of corner evidence found and/or method applied in restoring or reestablishing corner:

G-12
Found 4" Harrison monument and accepted as a careful and faithful perpetuation of the position of the original corner.

Centerline of pavement E. 14.2'
10" Pine SE. 88.90'
16" Maple NNW 92.85'
Tel. Ped. W. 32.86'
P.P. E. 66.09'

C. Description of monument for corner and accessories established to perpetuate locating the position of the corner:

G-12 4" Harrison Cast Iron Monument
O.C. Remon Tag & Nail in S. side of P.P. E. 66.17'
O.C. Remon Tag & Nail in S. side 12" Pine S 73 degrees E 89.23'
O.C. Remon Tag & Nail in E. side 20" Maple N 14 degrees W 92.14'
East face of Telephone pedestal N 89 degrees W 32.43'
Centerline of pavement E 14.2'
(Tape)

STATE OF MICHIGAN
CARL P. ENGLERT JR.
LAND SURVEYOR
No. 18987
REGISTERED LAND SURVEYOR

Signed by Carl P. Englert Jr. Date December 3, 1993

Surveyor's Michigan License No. 18987

FORM APPROVED BY MICHIGAN STATE BOARD OF LAND SURVEYORS, JAN. 28, 1971
REVISED MAY 14, 1975
REVISED JAN., 1983