

1933

Ottawa County Remonumentation

RECORDED

93 DEC 15 AM 9:29

COMMISSION

LAND CORNER RECORDATION CERTIFICATE

Filing Requirement of Act 74, Mich. P.A. 1970

For corners in

REGISTER OF DEEDS
OTTAWA COUNTY, MI

<u>Ottawa</u> (County)	Located In:	Corner Code #
	<u>Robinson Township</u>	
1. Public Land Survey	T <u>7N</u> R <u>15W</u>	<u>G-13</u>
	T _____ R _____	<u>SW corner</u>
	T _____ R _____	<u>Section 34</u>
	T _____ R _____	_____
2. Property Controlling in Section	S _____ T _____ R _____	_____
	S _____ T _____ R _____	_____
3. Miscellaneous Property in Sec.	S _____ T _____ R _____	_____
	S _____ T _____ R _____	_____

Register of Deeds Stamp & File Number

4. Lot No. _____, Recorded Plat _____
 5. Private Claims _____

A	B	C	D	E	F	G	H	I	J	K	L	M
2	6	5	4	3	2	1						
3												
4	7	8	9	10	11	12						
5												
6	18	17	16	15	14	13						
7												
8	19	20	21	22	23	24						
9												
10	30	29	28	27	26	25						
11												
12	31	32	33	34	35	36						
13												

Carl P. Englert Jr.
 I, _____, in a field survey on July 8, 19 93, do hereby certify that under requirements of P.A. 74, Michigan P.A. of 1970, the corner points mentioned in lines 1 and 2 above were in conformance with regulations and rules therefore as required in the current manual of survey instructions of the United States Department of the Interior, Bureau of Land Management or by a decree of a Court of Law and/or that the corner points mentioned in lines 3, 4 and 5 above were in conformance with the rules of the Michigan Board of Land Surveyors or by a Decree of a Court of Law; established, re-established, monumented, re-monumented, recovered, found as expressed below:

NOTE: Not more than 4 corners, all in the same town and range, may be recorded on this certificate.

A. Description of original monument and accessories and/or subsequent restoration:


G-13 L.C.R.C., Liber 6, Page 144, (6-11-91) Fd. C.I.M., Raised C.I.M. P.P. South 51.75 P.P. ESE 75.14 Twin Maple NW 82.03 Olive Twp. corner W. 69.31	L.C.R.C. Liber 6, Page 132, (6-24-91) Fd. 3/4" pipe in Mon. box, Set C.I.M W. 69.30 Olive Twp corner E. 25.9 to centerline 120th Ave. S. 51.71 to PK. nail in P.P. SW 46.26 to bolt on centerline S. en C.M.P. NW 48.46 to bolt on centerline N. en C.M.P.
---	--

B. Description of corner evidence found and/or method applied in restoring or reestablishing corner:

G-13 Found 4" Harrison monument in Mon. box and accepted as a careful and faithful perpetuation of the position of the original monument.	W. 69.30 to Olive Twp. corner Twin Maple NW 82.03 SW 46.26 to bolt on centerline S. en C.M.P. NW 48.46 to bolt on centerline N. en C.M.P.
--	--

C. Description of monument for corner and accessories established to perpetuate locating the position of the corner:

G-13 Set O.C. Remon. Cap over 4" Harrison Mon. in mon. box
 O.C. Remon. Tag & Nail in E. side P.P. S 54 degrees W 101.15'
 O.C. Remon. Tag & Nail in W. side P.P. S 01 degrees W 53.14'
 O.C. Remon. Tag & Nail in N. side P.P. S 74 degrees E 96.57'
 O.C. Remon. Tag & Nail in NW. side P.P. N 56 degrees E 66.54'
 Olive Township corner West 69.30'
 (EDM)

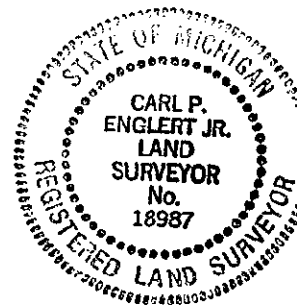

Signed by Carl P. Englert Jr. Date December 3, 1993
 Surveyor's Michigan License No. 18987