

SURVEY & REMONUMENTATION

APR 05 1996

OTTAWA COUNTY REMONUMENTATION AND CORNER RECORDATION CERTIFICATE
Filing Requirement of Act 74, Mich. P.A. 1970

For corners in Ottawa (County) Robinson Twp. Located In: Corner Code #H - 3

1. Public Land Survey	T <u>7</u> N R <u>15</u> W	<u>S 1/4 Corner</u>
	T _____ R _____	<u>Section 3</u>
	T _____ R _____	_____
	T _____ R _____	_____
2. Property Controlling in Section	S _____ T _____ R _____	_____
	S _____ T _____ R _____	_____
3. Miscellaneous Property in Sec.	S _____ T _____ R _____	_____
	S _____ T _____ R _____	_____

RECORDED
 95 NOV 29 PM 1:48
Richard Robinson
 REGISTER OF DEEDS
 OTTAWA COUNTY, MI
Register of Deeds Stamp & File Number

4. Lot No. _____, Recorded Plat _____
 5. Private Claims _____

I, Carl P. Englert, Jr., in a field survey on October 16, 19 95, do hereby certify that under requirements of P.A. 74, Michigan P.A. of 1970, the corner points mentioned in lines 1 and 2 above were in conformance with regulations and rules therefore as required in the current manual of survey instructions of the United States Department of the Interior, Bureau of Land Management or by a decree of a Court of Law and/or that the corner points mentioned in lines 3, 4 and 5 above were in conformance with the rules of the Michigan Board of Land Surveyors or by a Decree of a Court of Law; established, re-established, monumented, re-monumented, recovered, found as expressed below:

A	B	C	D	E	F	G	H	I	J	K	L	M
2	6	5	4	3	2	1						
3							●					
4	7	8	9	10	11	12						
5												
6	18	17	16	15	14	13						
7												
8	19	20	21	22	23	24						
9												
10	30	29	28	27	26	25						
11												
12	31	32	33	34	35	36						
13												

NOTE: Not more than 4 corners, all in the same town and range, may be recorded on this certificate.

A. Description of original monument and accessories and/or subsequent restoration:

H - 3 1/4 corner common to Sections 3 & 10	LCRC Liber 1, Page 47
Original Corner set May, 1832	Found Steel Bar
by Calvin Britain	Nail in face of 8" Oak NNE 59.71'
Set post on True Line	Nail in face of Tw. 12" Maple NE 52.09'
Birch 6" S 12° W 17 Links	Nail in face of 6" Cherry ENE 77.28'
Birch 10" N 40° W 24 Links	Nail in face of 8" Poplar ENE 63.55'
	S. End of Conc. Culvert S 3.70'

see other side

B. Description of corner evidence found and/or method applied in restoring or reestablishing corner:


H - 3 1/4 Corner common to Sections 3 & 10
 Found 10" Section of CIM on angle. Cut hole in abandoned concrete culvert and set 3/4" X 2' Iron Bar with Remonumentation Cap from accessories.
 Found 6" Cherry ENE 77.28' (in face)
 Found 8" Oak NNE 59.71' (in face)
 Found 14" Maple NE 52.28' (in face)
 S. end conc. culvert S 3.70'
 Found capped iron N 33.03'

P.A. 345 OTTAWA COUNTY
 PEER APPROVED 11-20-95
Richard P. Hedewold
 R D N

Accepted as a careful and faithful perpetuation of the position of the original corner.

C. Description of monument for corner and accessories established to perpetuate locating the position of the corner:

H - 3 1/4 Corner common to sections 3 & 10
 3/4" Iron Bar 2' Long with Ottawa County Remonumentation Cap.
 Ottawa County Remonumentation Nail and Tag in W. Side 12" Aspen N 7° W 40.65'
 Ottawa County Remonumentation Nail and Tag in SE Side 16" Oak N 42° E 37.19'
 Ottawa County Remonumentation Nail and Tag in N. Side 8" Maple S 77° W 153.37'
 SE corner of Metal Building N 16° W 99.04'

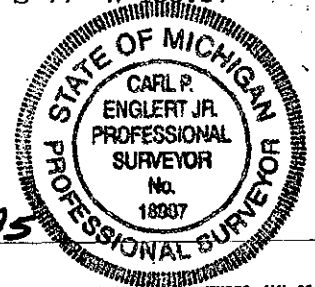

Signed by Carl P. Englert Jr. Date 10/17/1995
 Surveyor's Michigan License No. 18987

Robinson Township T. 7 N, R 15 W
H - 3 Liber 1, Page 629 September 18, 1972
Found 3/4" Rod
ENE 63.89' 8" Aspen
NE 52.28' 14" Maple
NNE 59.8 8" Oak

H - 3 Liber 3, Page 349
Fd Steel Bar
NNE 8" Oak 59.71'
S. End Culvert 3.70'
ENE 8" Poplar 63.55'

H - 3 Liber 4, Page 141
Fd Iron Bar Set CIM
8" Oak NNE 59.71'
6" Cherry ENE 77.28'
8" Aspen ENE 63.89'
12" Tw Maple NE 52.09'

* 11.00 CORNER