

**SURVEY &
REMONUMENTATION**

DEC 16 1996

COMMISSION

OTTAWA COUNTY REMONUMENTATION
LAND CORNER RECORDATION CERTIFICATE
Filing Requirement of Act 74, Mich. P.A. 1970

For corners in

Ottawa Located in: Corner Code #
(County) Robinson Township

1. Public Land Survey T7N R15W H-9
T R S 1/4 corner
T R Section 22
T R
2. Property Controlling S T R
in Section S T R
3. Miscellaneous S T R
Property in Sec. S T R

RECORDED
96 NOV 14 AM 11:21
R. J. ...
REGISTER OF DEEDS
OTTAWA COUNTY, MI
Register of Deeds Stamp & File Number

4. Lot No. _____, Recorded Plat _____
5. Private Claims _____

I, Carl P. Englert, in a field survey on 9/10, 1996 do hereby state that under requirements of P.A. 74, Michigan P.A. of 1970, the corner points mentioned in lines 1 and 2 above were in conformance with regulations and rules therefore as required in the current manual of survey instructions of the United States Department of the Interior, Bureau of Land Management or by a decree of a Court of Law and/or that the corner points mentioned in lines 3, 4 and 5 above were in conformance with the rules of the Michigan Board of Land Surveyors or by a Decree of a Court of Law; established, re-established, monumented, recovered, found as expressed below:

NOTE: Not more than 2 corners, all in the same town and range, may be recorded on this certificate.

1	A	B	C	D	E	F	G	H	I	J	K	L	M
2	6		5		4		3		2		1		
3													
4	7		8		9		10		11		12		
5													
6	19		17		16		15		14		13		
7													
8	19		20		21		22		23		24		
9													
10	30		29		28		27		26		25		
11													
12	31		32		33		34		35		36		
13													

A. Description of original monument and accessories and/or subsequent restoration:

H-9 1/4 Corner Common to Sections 22 & 27
G.L.O. May 1832 by Calvin Britain
Tamarack 1/4 Sec. Post.

LCRC Liber 2, Page 643 Oct. 1974
Fd. Angle Iron
E.N.E. 4.05' Triple Birch
S.W. 35.79' 20" Ash
N. 6.24' Edge of Pavement
W.S.W. 76.72' 24" Pine

See other side

B. Description of corner evidence found and/or method applied in restoring or reestablishing corner:

H-9 1/4 Corner Common to Sections 22 & 27
Found Cast Iron Monument 10" deep
Found 18" White Pine S.W. 35.12'
Found 22" White Pine S.W. 76.74'
Found 12" White Pine N.E. 68.77'

PA. 345 OTTAWA COUNTY
PEER APPROVED 9-16-96
C.P. Englert


Accepted as a careful and faithful perpetuation of the original position of the corner.

C. Description of monument for corner and accessories established to perpetuate locating the position of the corner:

H-9 1/4 Corner Common to Sections 22 & 27
4" Harrison Cast Iron Monument
O.C. Remon. Nail & Tag in S. Side 12" Tw. Birch S75°E 140.72'
O.C. Remon. Nail & Tag in W. Side 16" W. Pine N18°E 69.48'
O.C. Remon. Nail & Tag in N.W. Side 22" W. Pine S50°W 35.50'
O.C. Remon. Nail & Tag in N. Side 30" W. Pine S74°W 75.94'
North 7.6'± to edge of pavement

Signed by Carl P. Englert

Date 9/16/1996

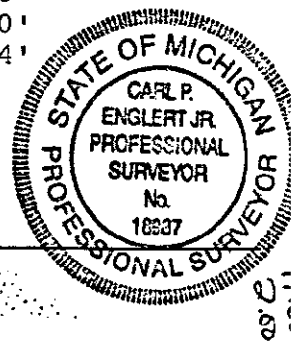

SURVEY &
REMONUMENTATION

DEC 16 1996

COMMISSION

H-9 1/4 Corner Common to Sections 22 & 27 T7N, R15W
LCRC Liber 3, Page 38 March 1976
Found Angle Iron
20" Pine S.W. 35.79'
24" Pine W.S.W. 76.72'
Edge of pavement N. 6.24'

LCRC Liber 4, Page 281 January 1982
Fd. Angle Iron. Set Cast Iron Monument
18" White Pine S.W. 35.12'
22" White Pine S.W. 76.74'
12" White Pine N.E. 68.77
Tele. Ped. N.W. 71.55'