

**SURVEY & REMONUMENTATION**

**FEB 27 1998**

RECORDED

**SECTION**

**OTTAWA COUNTY REMONUMENTATION  
LAND CORNER RECORDATION CERTIFICATE  
Filing Requirement of Act 74, Mich. P.A. 1970**

**RECORDED**

For corners in

<u>Ottawa</u> (County)	Located In: Robinson Township	Corner Code #
1. Public Land Survey	T <u>7N</u> R <u>15W</u>	<u>I-2</u> <u>W 1/4 corner</u> <u>Section 2</u>
	T ___ R ___	___
	T ___ R ___	___
	T ___ R ___	___
2. Property Controlling in Section	S ___ T ___ R ___	___
	S ___ T ___ R ___	___
3. Miscellaneous Property in Sec.	S ___ T ___ R ___	___
	S ___ T ___ R ___	___

97 OCT 30 AM 11:00

*Delia Gant*

Register of Deeds  
Ottawa County, MI

Register of Deeds Stamp & File Number

4. Lot No. \_\_\_\_\_, Recorded Plat \_\_\_\_\_  
5. Private Claims \_\_\_\_\_

I, Carl P. Englert, in a field survey on 2/27, 19 97 do hereby state that under requirements of P.A. 74, Michigan P.A. of 1970, the corner points mentioned in lines 1 and 2 above were in conformance with regulations and rules therefore as required in the current manual of survey instructions of the United States Department of the Interior, Bureau of Land Management or by a decree of a Court of Law and /or that the corner points mentioned in lines 3, 4 and 5 above were in conformance with the rules of the Michigan Board of Land Surveyors or by a Decree of a Court of Law; established, re-established, monumented, recovered, found as expressed below:

	A	B	C	D	E	F	G	H	I	J	K	L	M
1									⊙				
2	6	5	4	3	2	1							
3													
4	7	8	9	10	11	12							
5													
6	18	17	16	15	14	13							
7													
8	19	20	21	22	23	24							
9													
10	30	29	28	27	26	25							
11													
12	31	32	33	34	35	36							
13													

NOTE: Not more than 2 corners, all in the same town and range, may be recorded on this certificate.

A. Description of original monument and accessories and/or subsequent restoration:

I-2 1/4 corner common to Sections 2 and 3  
 G.L.O. 1832 Calvin Britain Liber 2, Page 809 (4-17-75)  
 Set 1/2 Mile Post I-2 Found Steel Bar  
 Pine 24" S80°E 23 links 30" Oak ENE 59.15'  
 Pine 20" N62°W 12 links Triple Oak SE 49.15'  
 8" Oak NNW 35.18'  
 Iron N 33.00'

See Other Side

B. Description of corner evidence found and/or method applied in restoring or reestablishing corner:


I-2 1/4 corner common to Sections 2 and 3  
 Found 4" Harrison Cast Iron Monument 8" deep in Centerline Gravel Road  
 Found 36" Oak NE 59.08'  
 Found 16" Triple Oak SE 49.11'  
 Found Iron Stake North 33.00'  
 Found 16" Pine NW 53.10'  
 Found 8" Oak NNW 35.15'

OTTAWA COUNTY  
PEER APPROVED 9-15-97

Accepted as a careful and faithful perpetuation of the original position of the corner.

C. Description of monument for corner and accessories established to perpetuate locating the position of the corner:

I-2 1/4 corner common to Sections 2 and 3  
 4" Harrison Cast Iron Monument  
 O.C. Remon Tag & Nail in S Side 20" Pine N60°W 61.51'  
 O.C. Remon Tag & Nail in NW Side 30" Oak N66°E 59.09'  
 O.C. Remon Tag & Nail in NW Side 8" Cherry S30°W 39.04'  
 O.C. Remon Tag & Nail in SW Side Triple 18" Oak S40°E 49.03'

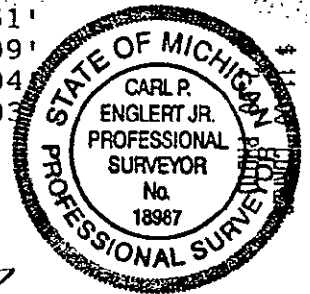

Signed by Carl P. Englert Jr.  
 Surveyor's Michigan License No. 18987

Date 9/15/1997

Robinson Township Section 3, Town 7 North, Range 15 West  
Liber 3, Page 349 (5-29-79)  
I-2 Found 5/8" Rod  
N Twin Oak 35.23'  
SE Triple Oak 49.15'

Robinson Township Section 3, Town 7 North, Range 15 West  
Liber 4, Page 205  
I-2 Found Iron Bar  
Set Cast Iron Monument  
13" Pine NW 53.10'  
30" Oak ENE 59.08'  
8" Oak NNW 35.15'  
14" Triple Oak SE 49.11' (12-19-80)

**SURVEY &  
REMONUMENTATION**

**FEB 27 1998**

**SECTION**