

SURVEY & REMONUMENTATION

APR 24 1995

OTTAWA COUNTY REMONUMENTATION LAND CORNER RECORDATION CERTIFICATE Filing Requirement of Act 74, Mich. P.A. 1970

RECORDED

94 DEC 15 AM 11:51

For corner **COMMISSION**

D. J. ...
REGISTER OF DEEDS
OTTAWA COUNTY, MI

<u>Ottawa</u> (County)	Located In: Robinson Twp.	Corner Code # <u>I-5</u>
1. Public Land Survey	T <u>7</u> R <u>15</u>	<u>Northeast</u> <u>Corner</u> <u>Section 15</u>
2. Property Controlling In Section	S ___ T ___ R ___	
3. Miscellaneous Property in Sec.	S ___ T ___ R ___	

Register of Deeds Stamp & File Number

4. Lot No. _____, Recorded Plat _____
5. Private Claims _____

	A	B	C	D	E	F	G	H	I	J	K	L	M
2	6	5	4	3	2	1							
3													
4	7	8	9	10	11	12							
5													
6	13	17	16	15	14	13							
7													
8	19	20	21	22	23	24							
9													
10	30	29	28	27	26	25							
11													
12	31	32	33	34	35	36							
13													

I, Carl P. Englert in a field survey on December 01, 19 94, do hereby certify that under requirements of P.A. 74, Michigan P.A. of 1970, the corner points mentioned in lines 1 and 2 above were in conformance with regulations and rules therefore as required in the current manual of survey instructions of the United States Department of the Interior, Bureau of Land Management or by a decree of a Court of Law and/or that the corner points mentioned in lines 3, 4 and 5 above were in conformance with the rules of the Michigan Board of Land Surveyors or by a Decree of a Court of Law; established, re-established, monumented, re-monumented, recovered, found as expressed below:

NOTE: Not more than 4 corners, all in the same town and range, may be recorded on this certificate.

A. Description of original monument and accessories and/or subsequent restoration:

I-5 corner common to Sections 10, 11, 14 & 15
Original Gov't corner set May 1832
by Calvin Britain D.S.

Liber 4, Page 255 (12/3/81)
Set cast iron Mon.
Power pole SE 65.47'
Telephone Pole NE 112.49'
9" Poplar ESE 82.80'
8" Apple NW 78.18'

Set Corner
Beech 12" N64°E 26 Links
Beech 12" West 28 Links

(See Back of Page)

B. Description of corner evidence found and/or method applied in restoring or reestablishing corner:

I-5 corner common to Sections 10, 11, 14 & 15

Found 3" Harrison Cast Iron Mon. in Mon. Box at E Intersection 4" deep
Found Power Pole S.E. (No Nail)
Found Telephone Pole N.E. 112.30'
Found 15" Pine S.W. 117.35'
Found 8" Apple N.W. 78.18'

PA. 345 OTTAWA COUNTY
PEER APPROVED 12/12/94


Victor D. Hedewald

Accepted as a careful and faithful perpetuation of the original corner.

C. Description of monument for corner and accessories established to perpetuate locating the position of the corner:

I-5 corner common to Sections 10, 11, 14 & 15

3" Harrison Cast Iron Mon. In Mon. Box
O.C. Remon. Tag & Nail in N. side Power Pole S53°W 63.83'
O.C. Remon. Tag & Nail in E. side Power Pole N14°E 112.75'
O.C. Remon. Tag & Nail in S.E. side 18" Pine S43°W 117.62'
O.C. Remon. Tag & Nail in S. side 10" Apple N46°W 77.82'

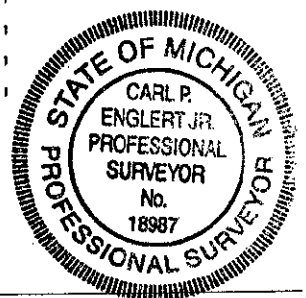

Signed by Carl P. Englert
Surveyor's Michigan License No. 18987

Date 12/5/94

LCRC Liber 1, Page 659 (9/8/72)

I-5

Found Angle Iron

P.P.	S.E. 65.45'
St. Sign	E. 27.50'
Tel. Pole	N.E. 112.30'
15" Pine	S.W. 117.35'
Iron Pipe	E. 33.14'

