

SURVEY & REMONUMENTATION

APR 24 1995

**OTTAWA COUNTY REMONUMENTATION
LAND CORNER RECORDATION CERTIFICATE
Filing Requirement of Act 74, Mich. P.A. 1970**

RECORDED

94 DEC 15 AM 11:52

For corners in **COMMISSION**

D. J. Williams
REGISTER OF DEEDS
OTTAWA COUNTY, MI

<u>Ottawa</u> (County)	Located In: Robinson Twp.	Corner Code # I-7
1. Public Land Survey	T <u>7</u> R <u>15</u>	<u>I-7</u>
	T _____ R _____	<u>SE Corner</u>
	T _____ R _____	<u>Section 15</u>
	T _____ R _____	_____
2. Property Controlling in Section	S _____ T _____ R _____	_____
	S _____ T _____ R _____	_____
3. Miscellaneous Property in Sec.	S _____ T _____ R _____	_____
	S _____ T _____ R _____	_____

Register of Deeds Stamp & File Number

4. Lot No. _____, Recorded Plat _____
5. Private Claims _____

A	B	C	D	E	F	G	H	I	J	K	L	M
2	6	5	4	3	2	1						
3												
4	7	8	9	10	11	12						
5												
6	18	17	16	15	14	13						
7												
8	19	20	21	22	23	24						
9												
10	30	29	28	27	26	25						
11												
12	31	32	33	34	35	36						
13												

I, Carl P. Englert, in a field survey on December 01, 19 94, do hereby certify that under requirements of P.A. 74, Michigan P.A. of 1970, the corner points mentioned in lines 1 and 2 above were in conformance with regulations and rules therefore as required in the current manual of survey instructions of the United States Department of the Interior, Bureau of Land Management or by a decree of a Court of Law and/or that the corner points mentioned in lines 3, 4 and 5 above were in conformance with the rules of the Michigan Board of Land Surveyors or by a Decree of a Court of Law; established, re-established, monumented, re-monumented, recovered, found as expressed below:

NOTE: Not more than 4 corners, all in the same town and range, may be recorded on this certificate.

A. Description of original monument and accessories and/or subsequent restoration:
I-7 corner common to Sections 14, 15, 22 & 23
Original Gov't corner set May, 1832 by Calvin Britain D.S.
LCRC Liber 2, Page 793, (7/24/75)
I-7
Found Cast Iron Monument
SE 14" Oak 49.24'
SSE 10" Maple 39.28'
NW Trip. Cherry 67.46'
SW 8" Maple 42.33'


(See Back of Page)

B. Description of corner evidence found and/or method applied in restoring or reestablishing corner:
I-7 corner common to Sections 14, 15, 22 & 23
Found 3" Harrison Cast Iron Mon. at \oint Intersection, 5" deep
Found 8" Maple S.W. 42.33'

PA. 345 OTTAWA COUNTY
PEER APPROVED 12/12/94
Wendy D. Hedrick

Accepted as a careful and faithful perpetuation of the original position of the corner

C. Description of monument for corner and accessories established to perpetuate locating the position of the corner:
I-7 corner common to Sections 14, 15, 22 & 23
3" Harrison Cast Iron Mon.
O.C. Remon. Tag & Nail in N.E. side Power Pole S42°E 44.12'
O.C. Remon. Tag & Nail in S. side 26" Maple N73°W 121.26'
O.C. Remon. Tag & Nail in W. side 12" Maple S11°W 42.89'
O.C. Remon. Tag & Nail in S.W. side 12" B.Cherry N46°W 89.86'

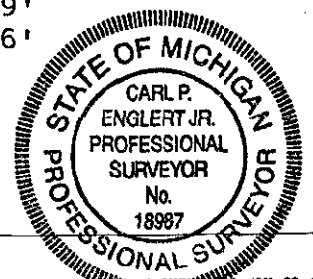

Signed by Carl P. Englert Jr. Date 12/5/94
Surveyor's Michigan License No. 18987

LCRC Liber 2, Page 581, (6/28/74)

I-7

Set Cast Iron Monument

28" Maple	NW	41.84'
10" Maple	SE	39.27'
12" W. Oak	SE	49.21'
6" St. Sign	SE	23.61'
8" Oak	SW	42.28'

RECORDED
INDEXED
JUN 28 1974
LIBRARY