

**SURVEY & REMONUMENTATION**

APR 24 1995

**OTTAWA COUNTY REMONUMENTATION  
LAND CORNER RECORDATION CERTIFICATE  
Filing Requirement of Act 74, Mich. P.A. 1970**

RECORDED

94 DEC 15 AM 11:50

For corners in **COMMISSION**

*Phyllis Holman*  
REGISTER OF DEEDS  
OTTAWA COUNTY, MI

Ottawa (County) Located In: Robinson Twp. Corner Code #:


1. Public Land Survey	T <u>7</u> R <u>15</u>	J-5
	T ___ R ___	N 1/4 Corner
	T ___ R ___	Section 14
	T ___ R ___	
2. Property Controlling in Section	S ___ T ___ R ___	
	S ___ T ___ R ___	
3. Miscellaneous Property in Sec.	S ___ T ___ R ___	
	S ___ T ___ R ___	

4. Lot No. \_\_\_\_\_, Recorded Plat \_\_\_\_\_

5. Private Claims \_\_\_\_\_

Register of Deeds Stamp & File Number

I, Carl P. Englert, in a field survey on December 01, 19 94, do hereby certify that under requirements of P.A. 74, Michigan P.A. of 1970, the corner points mentioned in lines 1 and 2 above were in conformance with regulations and rules therefore as required in the current manual of survey instructions of the United States Department of the Interior, Bureau of Land Management or by a decree of a Court of Law and/or that the corner points mentioned in lines 3, 4 and 5 above were in conformance with the rules of the Michigan Board of Land Surveyors or by a Decree of a Court of Law; established, re-established, monumented, re-monumented, recovered, found as expressed below:

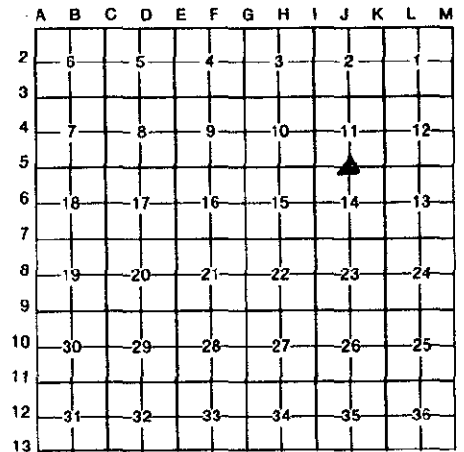

**NOTE: Not more than 4 corners, all in the same town and range, may be recorded on this certificate.**

A. Description of original monument and accessories and/or subsequent restoration:  
J-5 1/4 corner common to Sections 11 & 14  
Original Gov't corner set May 1832  
by Calvin Britain D.S.

LCRC Liber 2, Page 779 (2/19/75)  
J-5  
Set Cast Iron Monument  
30" Maple N 50W 14.45'  
8" Hemlock N60E 26.47'  
12" Cherry N50W 46.60'  
E Ditches N 6'  
W 6'

Set Post  
Black Ash 10" S10W 13 Links  
Black Ash 10" N16E 17 Links

B. Description of corner evidence found and/or method applied in restoring or reestablishing corner:  
J-5 1/4 corner common to Sections 11 & 14

Found 3" Harrison Cast Iron Mon.  
Found 30" Maple N 50W 14.45'  
Found 8" Hemlock N60E 26.47'  
Found 12" Cherry N50W 46.60'  
E Ditches N 6'  
W 6'


P.A. 345 OTTAWA COUNTY  
PEER APPROVED 12/12/94

*Harvey D. Hedewell*

Accepted as a careful and faithful perpetuation of the original position of the corner.

C. Description of monument for corner and accessories established to perpetuate locating the position of the corner:  
J-5 1/4 corner common to Sections 11 & 14

3" Harrison Cast Iron Mon.  
O.C. Remon. Tag & Nail in E. side 32" Maple N05W 14.53'  
O.C. Remon. Tag & Nail in W. side 20" Oak S02W 30.29'  
O.C. Remon. Tag & Nail in E. side 14" Hemlock N48E 26.46'  
O.C. Remon. Tag & Nail in W. side 14" Cherry N43W 46.51'

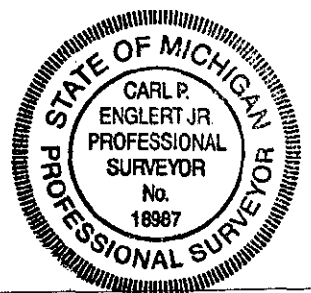

Signed by Carl P. Englert Jr.  
Surveyor's Michigan License No. 18987

Date 12/5/94