

SURVEY & REMONUMENTATION

APR 24 1995

**OTTAWA COUNTY REMONUMENTATION
LAND CORNER RECORDATION CERTIFICATE
Filing Requirement of Act 74, Mich. P.A. 1970**

RECORDED
94 DEC 15 AM 11:52

For corners **COMMISSION**

Edythe Robinson
REGISTER OF DEEDS
OTTAWA COUNTY, MI

<u>Ottawa</u> (County)	Located In: <u>Robinson Twp.</u>	Corner Code # <u>J-7</u>
1. Public Land Survey	T <u>7</u> R <u>15</u>	<u>J-7</u>
	T ___ R ___	<u>S 1/4 Corner</u>
	T ___ R ___	<u>Section 14</u>
	T ___ R ___	_____
2. Property Controlling in Section	S ___ T ___ R ___	_____
	S ___ T ___ R ___	_____
3. Miscellaneous Property in Sec.	S ___ T ___ R ___	_____
	S ___ T ___ R ___	_____

Register of Deeds Stamp & File Number

4. Lot No. _____, Recorded Plat _____
5. Private Claims _____

I, Carl P. Englert in a field survey on December 01, 19 94, do hereby certify that under requirements of P.A. 74, Michigan P.A. of 1970, the corner points mentioned in lines 1 and 2 above were in conformance with regulations and rules therefore as required in the current manual of survey instructions of the United States Department of the Interior, Bureau of Land Management or by a decree of a Court of Law and/or that the corner points mentioned in lines 3, 4 and 5 above were in conformance with the rules of the Michigan Board of Land Surveyors or by a Decree of a Court of Law; established, re-established, monumented, re-monumented, recovered, found as expressed below:

	A	B	C	D	E	F	G	H	I	J	K	L	M
2	6	5	4	3	2	1							
3													
4	7	8	9	10	11	12							
5													
6	18	17	16	15	14	13							
7													
8	19	20	21	22	23	24							
9													
10	30	29	28	27	26	25							
11													
12	31	32	33	34	35	36							
13													

NOTE: Not more than 4 corners, all in the same town and range, may be recorded on this certificate.

A. Description of original monument and accessories and/or subsequent restoration:

J-7 1/4 corner common to Sections 14 & 23
Original Gov't corner set May 1832
by Calvin Britain D.S.

Liber 2, Page 745 (2/20/74)

Set Post
Beech 10" N29°E 19 Links
Beech 7" S50°W 21 Links

J-7
Cast Iron Monument (Found)
18" Oak S.E. 38.96'
10" Maple N.E. 43.93'
Tw. Maple N.N.W. 28.25'
24" Oak S.S.W. 19.87'

(See Back of Page)

B. Description of corner evidence found and/or method applied in restoring or reestablishing corner:

J-7 1/4 corner common to Sections 14 & 23

Found 3" Harrison Cast Iron Mon. 1.5' S. of $\frac{1}{2}$ of road, 1" deep (Broken Top)
Found 18" Oak S.E. 38.96'
Found 10" Maple N.E. 43.93'
Found Tw. Maple N.N.W. 28.25'
Found 24" Oak S.S.W. 19.87'

P.A. 345 OTTAWA COUNTY

PEER APPROVED 12/12/94

Accepted as a careful and faithful perpetuation of the original position of the corner.


C. Description of monument for corner and accessories established to perpetuate locating the position of the corner:

J-7 1/4 corner common to Sections 14 & 23

3" Harrison Cast Iron Mon. (Broken Top)
O.C. Remon. Tag & Nail in N.E. side 14" Oak S37°E 66.06'
O.C. Remon. Tag & Nail in S.E. side 8" Tw Maple N29°E 48.23'
O.C. Remon. Tag & Nail in W. side 14" Maple N21°W 45.04'
O.C. Remon. Tag & Nail in W. side 15" Oak S06°E 38.87'

Signed by Carl P. Englert Jr.
Surveyor's Michigan License No. 18987

Date 12/05/94

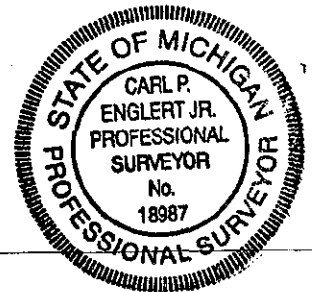

LCRC Liber 2, Page 581, (6/28/74)

J-7

Set Cast Iron Monument

8" Maple NE 43.91

Twin 6" Maple NNW 28.23'

24" Oak SE 38.93'

150 M
9.00
150 M
2.00
150 M
2.00