

RECORDED

1897

Ottawa County Remonumentation

RECORDED

93 DEC 15 AM 9:29

LAND CORNER RECORDATION CERTIFICATE

Filing Requirement of Act 74, Mich. P.A. 1970

COMMISSION

For corners in

<u>Ottawa</u> (County)	Located In:	Corner Code #
	<u>Robinson Township</u>	
1. Public Land Survey	T <u>7N</u> R <u>15W</u>	<u>J-11</u>
	T _____ R _____	<u>N 1/4 corner</u>
	T _____ R _____	<u>Section 35</u>
	T _____ R _____	_____
2. Property Controlling in Section	S _____ T _____ R _____	_____
	S _____ T _____ R _____	_____
3. Miscellaneous Property in Sec.	S _____ T _____ R _____	_____
	S _____ T _____ R _____	_____

D. J. ...
 REGISTER OF DEEDS
 OTTAWA COUNTY, MI

Register of Deeds Stamp & File Number

- 4. Lot No. _____, Recorded Plat _____
- 5. Private Claims _____

A	B	C	D	E	F	G	H	I	J	K	L	M
2	6	5	4	3	2	1						
3												
4	7	8	9	10	11	12						
5												
6	16	17	16	15	14	13						
7												
8	19	20	21	22	23	24						
9												
10	30	29	28	27	26	25						
11												
12	31	32	33	34	35	36						
13												

Carl P. Englert Jr.

I, _____, in a field survey on July 22, 19 93, do hereby certify that under requirements of P.A. 74, Michigan P.A. of 1970, the corner points mentioned in lines 1 and 2 above were in conformance with regulations and rules therefore as required in the current manual of survey instructions of the United States Department of the Interior, Bureau of Land Management or by a decree of a Court of Law and/or that the corner points mentioned in lines 3, 4 and 5 above were in conformance with the rules of the Michigan Board of Land Surveyors or by a Decree of a Court of Law; established, re-established, monumented, re-monumented, recovered, found as expressed below:

NOTE: Not more than 4 corners, all in the same town and range, may be recorded on this certificate.

A. Description of original monument and accessories and/or subsequent restoration:


- J-11
- L.C.R.C., Liber 4, Page 139, (12-10-80)
- Found Iron Bar, Set C.I.M.
- 2" Steel pipe S. 33.28'
- P.P. SSE. 28.51'
- 5" tree ESE. 69.10'
- North end culvert 13.00

B. Description of corner evidence found and/or method applied in restoring or reestablishing corner:

- J-11
- Found broken 4" Harrison Monument and accepted as a careful and faithful perpetuation of the position of the original corner.
- North end culvert 13.00

C. Description of monument for corner and accessories established to perpetuate locating the position of the corner:

- J-11 Replaced broken Harrison monument with 8" long 3/4" iron bar and O.C. Remon. cap in concrete over cross culvert.
- NE corner wood pump house S 22 degrees E 39.25'
- O.C. Remon. Tag & Nail in NW side P.P. S 02 degrees E 29.38'
- O.C. Remon. Tag & Nail in SE side P.P. N 85 degrees W 333.07'
- O.C. Remon Tag & Nail in SE side 12" Oak N 71 degrees W 263.77' (EDM)

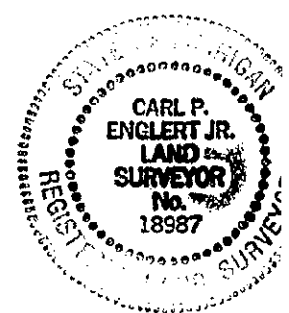

Signed by Carl P. Englert Jr. Date December 3, 1993
 Surveyor's Michigan License No. 18987