

Ottawa County Remonumentation

RECORDED

LAND CORNER RECORDATION CERTIFICATE
Filing Requirement of Act 74, Mich. P.A. 1970

93 DEC 15 AM 9:29

For corners in

COMMISSION

Richard Robinson
REGISTER OF DEEDS
OTTAWA COUNTY, MI

Ottawa
(County)

Located In: Robinson Township Corner Code # J-13

1. Public Land Survey T 7N R 15W J-13
T _____ R _____ S 1/4 corner
T _____ R _____ Section 35
T _____ R _____ _____

2. Property Controlling S _____ T _____ R _____
in Section S _____ T _____ R _____

3. Miscellaneous S _____ T _____ R _____
Property in Sec. S _____ T _____ R _____

4. Lot No. _____, Recorded Plat _____

5. Private Claims _____

Register of Deeds Stamp & File Number

Carl P. Englert Jr.

I, _____, in a field survey on November 11, 1993, do hereby certify that under requirements of P.A. 74, Michigan P.A. of 1970, the corner points mentioned in lines 1 and 2 above were in conformance with regulations and rules therefore as required in the current manual of survey instructions of the United States Department of the Interior, Bureau of Land Management or by a decree of a Court of Law and/or that the corner points mentioned in lines 3, 4 and 5 above were in conformance with the rules of the Michigan Board of Land Surveyors or by a Decree of a Court of Law; established, re-established, monumented, re-monumented, recovered, found as expressed below:

NOTE: Not more than 4 corners, all in the same town and range, may be recorded on this certificate.

	A	B	C	D	E	F	G	H	I	J	K	L	M
2	6		5		4		3		2		1		
3													
4	7		8		9		10		11		12		
5													
6	18		17		16		15		14		13		
7													
8	19		20		21		22		23		24		
9													
10	30		29		28		27		26		25		
11													
12	31		32		33		34		35		36		
13													

A. Description of original monument and accessories and/or subsequent restoration:

J-13
L.C.R.C. Liber 6, Page 78, (12-21-90)
Found H.E.I. iron, set C.I.M.
West 67.03' Olive Township corner
N 70 degrees E 114.70' nail in S. side P.P.
S 45 degrees E 45.16' nail in N, side 14" Mulberry
S 55 degrees W 46.97' nail in N. side P.P.
N 60 degrees W 179.45' nail in E. side 10" Elm


B. Description of corner evidence found and/or method applied in restoring or reestablishing corner:

J-13
Found broken Harrison Monument in Monument box and accepted as a careful and faithful perpetuation of the position of the original corner. Found all witnesses listed in "A" above.

C. Description of monument for corner and accessories established to perpetuate locating the position of the corner:

J-13 4" Harrison C.I.M. with broken top in monument box
O.C. Remon Tag & Nail in S. side P.P. N 71 degrees E 114.80'
O.C. Remon Tag & Nail in N. side 14" Mulberry S 78 degrees E 123.56'
O.C. Remon Tag & Nail in SE. side P.P. S 49 degrees W 47.30'
O.C. Remon Tag & Nail in NE. side 12" Elm N 71 degrees W 179.38'
Olive Township corner W. 67.03'
(EDM)

Signed by Carl P. Englert Jr. Date December 3, 1993
Surveyor's Michigan License No. 18987

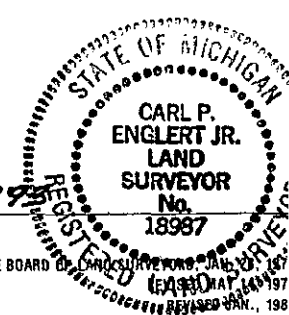

FORM APPROVED BY MICHIGAN STATE BOARD OF LAND SURVEYORS, JAN. 27, 1977 (REVISED JAN. 14, 1977)