

SURVEY &
REMONUMENTATION

APR 05 1996

OTTAWA COUNTY REMONUMENTATION
LAND CORNER RECORDATION CERTIFICATE
COMMISSION Filing Requirement of Act 74, Mich. P.A. 1970

For corners in

Robinson Twp.

Ottawa (County)	Located In:	Corner Code -#
1. Public Land Survey	T 7 N R 15 W	K - 3
	T ___ R ___	SE Corner
	T ___ R ___	Section 2
	T ___ R ___	
2. Property Controlling in Section	S ___ T ___ R ___	
	S ___ T ___ R ___	
3. Miscellaneous Property in Sec.	S ___ T ___ R ___	
	S ___ T ___ R ___	

RECORDED

95 NOV 29 PM 1:48

D. J. ...
REGISTER OF DEEDS
OTTAWA COUNTY, MI

Register of Deeds Stamp & File Number

4. Lot No. _____, Recorded Plat _____
5. Private Claims _____

	A	B	C	D	E	F	G	H	I	J	K	L	M
2	6	5	4	3	2	1							
3													
4	7	8	9	10	11	12							
5													
6	18	17	16	15	14	13							
7													
8	19	20	21	22	23	24							
9													
10	30	29	28	27	26	25							
11													
12	31	32	33	34	35	36							
13													

I, Carl P. Englert, Jr., in a field survey on October 16, 19 95, do hereby certify that under requirements of P.A. 74, Michigan P.A. of 1970, the corner points mentioned in lines 1 and 2 above were in conformance with regulations and rules therefore as required in the current manual of survey instructions of the United States Department of the Interior, Bureau of Land Management or by a decree of a Court of Law and/or that the corner points mentioned in lines 3, 4 and 5 above were in conformance with the rules of the Michigan Board of Land Surveyors or by a Decree of a Court of Law; established, re-established, monumented, re-monumented, recovered, found as expressed below:

NOTE: Not more than 4 corners, all in the same town and range, may be recorded on this certificate.

A. Description of original monument and accessories and/or subsequent restoration:

K - 3 Corner Common to Section 1, 2, 11, & 12
Original Corner Set May, 1832 by Calvin Britain
Pine 36" N 82° E 20 Links
Pine 28" N 74° W 30 Links

LCRC Liber 1, Page 659
September 8, 1972
Fd. Angle Iron
10" Oak SE 38.70'
18" Oak NE 27.45'
St. Sign NE 25.60'
P.P. NW 52.30'
12" Oak SW 88.60'

see other side

B. Description of corner evidence found and/or method applied in restoring or reestablishing corner:

K - 3 Corner common to Sections 1, 2, 11, & 12
Found 3" CIM in Mon Box on Road Centerline
Found Twin 15" Oak SE (no nail) 82.4'±
Found Twin 10" Oak East 53.71'
Found P.P. NW 51.47'


P.A. 345 OTTAWA COUNTY
PEER APPROVED 11-20-95

Maday P. Newbold
JDN

Accepted as a careful and faithful perpetuation of the position of the original corner.

C. Description of monument for corner and accessories established to perpetuate locating the position of the corner:

K - 3 3" CIM in Mon Box
Ottawa County Remonumentation Tag and Nail in SW side P.P. N 60° W 51.50'
Ottawa County Remonumentation Tag and Nail in SW side 16" Tw. Oak S 39° E 82.44'
Ottawa County Remonumentation Tag and Nail in N side 10" Tw. Oak S 80° E 53.68'
Ottawa County Remonumentation Tag and Nail in SE side 13" Oak N 44° E 75.60'

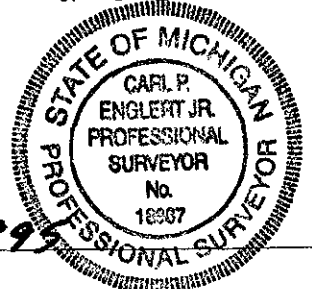

Signed by Carl P. Englert Jr.
Surveyor's Michigan License No. 18987

Date 10/18/1995

K - 3 Sec 11 - 7 - 15
LCRC Liber 5, Page 77
Fd Angle Iron, Set CIM
P.P. NW 51.47'
8" Oak SW 77.52'
Tw 12" Oak SE 82.43'
Tw 8" Oak E. 53.71'

\$ 11.00 CORNER