

Ottawa County Remonumentation

RECORDED

LAND CORNER RECORDATION CERTIFICATE

93 DEC 15 AM 9:29

Filing Requirement of Act 74, Mich. P.A. 1970

For corners in

COMMISSION

REGISTER OF DEEDS  
OTTAWA COUNTY, MI

<u>Ottawa</u> (County)	Located In:	Corner Code #
	<u>Robinson Township</u>	
1. Public Land Survey	T <u>7N</u> R <u>15W</u>	<u>K-11</u>
	T _____ R _____	<u>NE corner</u>
	T _____ R _____	<u>Section 35</u>
	T _____ R _____	_____
2. Property Controlling in Section	S _____ T _____ R _____	_____
	S _____ T _____ R _____	_____
3. Miscellaneous Property in Sec.	S _____ T _____ R _____	_____
	S _____ T _____ R _____	_____

Register of Deeds Stamp & File Number

4. Lot No. \_\_\_\_\_, Recorded Plat \_\_\_\_\_  
5. Private Claims \_\_\_\_\_

	A	B	C	D	E	F	G	H	I	J	K	L	M
2	6		5		4		3		2		1		
3													
4	7		8		9		10		11		12		
5													
6	18		17		16		15		14		13		
7													
8	19		20		21		22		23		24		
9													
10	30		29		28		27		26		25		
11													
12	31		32		33		34		35		36		
13													

Carl P. Englert Jr.

I, \_\_\_\_\_, in a field survey on July 22, 19 93, do hereby certify that under requirements of P.A. 74, Michigan P.A. of 1970, the corner points mentioned in lines 1 and 2 above were in conformance with regulations and rules therefore as required in the current manual of survey instructions of the United States Department of the Interior, Bureau of Land Management or by a decree of a Court of Law and/or that the corner points mentioned in lines 3, 4 and 5 above were in conformance with the rules of the Michigan Board of Land Surveyors or by a Decree of a Court of Law; established, re-established, monumented, re-monumented, recovered, found as expressed below:

NOTE: Not more than 4 corners, all in the same town and range, may be recorded on this certificate.

A. Description of original monument and accessories and/or subsequent restoration:

- |                            |                                       |                                     |
|----------------------------|---------------------------------------|-------------------------------------|
| K-11                       | L.C.R.C. Liber 1, Page 580, (8-21-72) | L.C.R.C. Liber 4, Page 82, (7-1-80) |
| Found angle iron           |                                       | Found angle iron, set C.I.M.        |
| T.P. SW 34.60'             |                                       | 18" Basswood ESE 101.27'            |
| T.P. SE 48.92'             |                                       | 11" Basswood SE 92.53'              |
| Centerline St. sign 30.09' |                                       | 12" Maple NW 87.47'                 |
| T.P. NW 52.91'             |                                       | 10" Maple WNW 106.32'               |
| 20" Basswood WSW 80.55'    |                                       |                                     |

B. Description of corner evidence found and/or method applied in restoring or reestablishing corner:


- |      |  |                                  |
|------|--|----------------------------------|
| K-11 | Found 4" Harrison monument with top broken off and accepted as a careful and faithful perpetuation of the position of the original corner. | 18" Basswood ESE 101.27' (Aspen) |
|------|--|----------------------------------|

C. Description of monument for corner and accessories established to perpetuate locating the position of the corner:

- K-11 Replaced Harrison Monument with 3' long 3/4" iron bar with O.C. Remon. Cap  
 O.C. Remon. Tag & Nail in SW side triple Maple S 40 degrees E 88.60'  
 O.C. Remon. Tag & Nail in N side 28" Ash S 72 degrees E 81.60'  
 O.C. Remon. Tag & Nail in E side P.P. N12 degrees W 144.38'  
 O.C. Remon. Tag & Nail in NE side 24" Twin Maple N 37 degrees W 85.71'  
 O.C. Remon. Tag & Nail in SW side 22" Aspen S 76 degrees E 100.87'  
 (EDM)

Signed by Carl P. Englert Jr.  
 Surveyor's Michigan License No. 18987

Date December 3, 1993

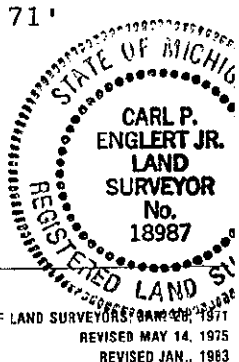

FORM APPROVED BY MICHIGAN STATE BOARD OF LAND SURVEYORS, BARR 426, 1971  
 REVISED MAY 14, 1975  
 REVISED JAN., 1983