

Ottawa County Remonumentation

RECORDED

93 DEC 15 AM 9:29

LAND CORNER RECORDATION CERTIFICATE
Filing Requirement of Act 74, Mich. P.A. 1970

For corners in

Ottawa

Ottawa
(County)

Located In: Corner Code #
Robinson Township

- 1. Public Land Survey T 7N R 15W K-12
T _____ R _____ East 1/4 Corner
T _____ R _____ Section 35
T _____ R _____
- 2. Property Controlling S _____ T _____ R _____
in Section S _____ T _____ R _____
- 3. Miscellaneous S _____ T _____ R _____
Property in Sec. S _____ T _____ R _____

D. Lyndis Robinson
REGISTER OF DEEDS
OTTAWA COUNTY, MI

Register of Deeds Stamp & File Number

- 4. Lot No. _____, Recorded Plat _____
- 5. Private Claims _____

	A	B	C	D	E	F	G	H	I	J	K	L	M
2	6		5		4		3		2				
3													
4	7		8		9		10		11		12		
5													
6	18		17		16		15		14		13		
7													
8	19		20		21		22		23		24		
9													
10	30		29		28		27		26		25		
11													
12	31		32		33		34		35		36		
13													

Carl P. Englert Jr.

I, _____, in a field survey on July 22, 19 93, do hereby certify that under requirements of P.A. 74, Michigan P.A. of 1970, the corner points mentioned in lines 1 and 2 above were in conformance with regulations and rules therefore as required in the current manual of survey instructions of the United States Department of the Interior, Bureau of Land Management or by a decree of a Court of Law and/or that the corner points mentioned in lines 3, 4 and 5 above were in conformance with the rules of the Michigan Board of Land Surveyors or by a Decree of a Court of Law; established, re-established, monumented, re-monumented, recovered, found as expressed below:

NOTE: Not more than 4 corners, all in the same town and range, may be recorded on this certificate.

A. Description of original monument and accessories and/or subsequent restoration:

K-12
L.C.R.C. Liber 4, Page 82, (7-1-93)
Found "T" iron from recorded ties, set C.I.M.
18" Maple SE 53.62'
10" Maple NE 71.70'
10" Maple SW 93.55'
Centerline St. sign NW 38.70'

B. Description of corner evidence found and/or method applied in restoring or reestablishing corner:


K-12
Found 4" Harrison Monument with broken top and accepted as a careful and faithful perpetuation of the position of the original corner, 18" Maple SE 53.62'
Centerline St. sign NW 38.70'

C. Description of monument for corner and accessories established to perpetuate locating the position of the corner:

K-12 Replaced broken Harrison Monument with 3' long 3/4" iron bar with Remno. Ca
O.C. Remon Tag & Nail in NE side 12" Maple N 31 degrees W 78.68'
O.C. Remon Tag & Nail in SE side 6" Maple N 40 degrees E 65.70'
O.C. Remon Tag & Nail in SW side 15" Maple S 44 degrees E 48.32'
O.C. Remon Tag & Nail in N side 16" Pepperridge S 83 degrees W 131.02'
O.C. Remon Tag & Nail in E side 12" Pepperridge S 10 degrees W 137.05'
(EDM)

Signed by Carl P. Englert Jr.
Surveyor's Michigan License No. 18987

Date December 3, 1993

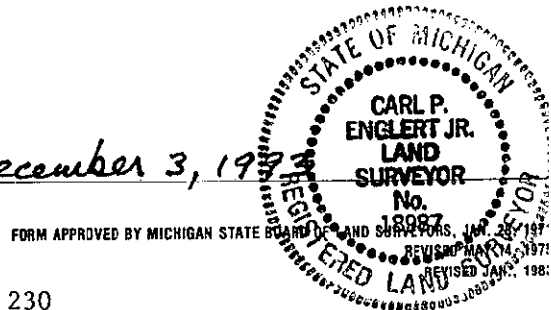

FORM APPROVED BY MICHIGAN STATE BOARD OF LAND SURVEYORS, JAN. 28, 1987, REVISED JAN. 1988