

LAND CORNER RECORDATION CERTIFICATE

93 DEC 15 AM 9:28

Filing Requirement of Act 74, Mich. P.A. 1970

For corners in

COMMISSION

REGISTER OF DEEDS
OTTAWA COUNTY, MI

Ottawa (County) Located In: Corner Code #
Robinson Township

1. Public Land Survey T 7N R 15W K-13
T R SE. Corner
T R Section 35
T R

2. Property Controlling S T R
in Section S T R

3. Miscellaneous S T R
Property in Sec. S T R

Register of Deeds Stamp & File Number

4. Lot No. _____, Recorded Plat _____
5. Private Claims _____

| | A | B | C | D | E | F | G | H | I | J | K | L | M |
|----|----|---|----|---|----|---|----|---|----|---|----|---|---|
| 2 | 6 | | 5 | | 4 | | 3 | | 2 | | 1 | | |
| 3 | | | | | | | | | | | | | |
| 4 | 7 | | 8 | | 9 | | 10 | | 11 | | 12 | | |
| 5 | | | | | | | | | | | | | |
| 6 | 18 | | 17 | | 16 | | 15 | | 14 | | 13 | | |
| 7 | | | | | | | | | | | | | |
| 8 | 19 | | 20 | | 21 | | 22 | | 23 | | 24 | | |
| 9 | | | | | | | | | | | | | |
| 10 | 30 | | 29 | | 28 | | 27 | | 26 | | 25 | | |
| 11 | | | | | | | | | | | | | |
| 12 | 31 | | 32 | | 33 | | 34 | | 35 | | 36 | | |
| 13 | | | | | | | | | | | | | |

Carl P. Englert Jr.

I, _____, in a field survey on November 11, 1993, do hereby certify that under requirements of P.A. 74, Michigan P.A. of 1970, the corner points mentioned in lines 1 and 2 above were in conformance with regulations and rules therefore as required in the current manual of survey instructions of the United States Department of the Interior, Bureau of Land Management or by a decree of a Court of Law and/or that the corner points mentioned in lines 3, 4 and 5 above were in conformance with the rules of the Michigan Board of Land Surveyors or by a Decree of a Court of Law; established, re-established, monumented, re-monumented, recovered, found as expressed below:

NOTE: Not more than 4 corners, all in the same town and range, may be recorded on this certificate.

A. Description of original monument and accessories and/or subsequent restoration:

K-13
L.C.R.C. Liber 4, Page 77, 7/1/80
Fd. Iron Bar from old ties, Set C.I.M.
C/L St. Sign S 25.63'
39" Cherry SW 102.67'
Nail in wood sign Post WSW 127.47'
Olive corner West 89.12'

L.C.R.C. Liber 6, Page 136, 5/24/9
Reset Cast Iron Mon.
W 89.11 Olive Corner
N 45 degrees W 72.90' Nail S side
N 70 degrees E 130.80' Nail S side
5" Hackberry
S 35 degrees E 125.50' P.K. W side
P.P.
S 40 degrees W 102.65' N&T in N Si

B. Description of corner evidence found and/or method applied in restoring or reestablishing corner: 86" Cherry


K-13
Found Harrison Mon. in Mon. Box
and accepted as a careful and
faithful perpetuation of the
position of the original corner.

W 89.11' Olive Corner
N 45 degrees W 72.90' S side P.P.
N 70 degrees E 130.80' S side
12" Hackberry
S 40degrees W 102.65' N side 36'
Cherry

C. Description of monument for corner and accessories established to perpetuate locating the position of the corner:

K-13 Harrison Cast Iron Monument in Mon. Box
O.C. Remon. Tag & Nail in S side 12" Hackberry N 69 degrees E 130.90'
O.C. Remon. Tag & Nail in W side P.P. S 31 degrees E 123.47'
O.C. Remon. Tag & Nail in E side 36" Cherry S 34 degrees W 104.12'
O.C. Remon. Tag & Nail in S side P.P. N 49 degrees W 73.35'
Olive corner West 89.11'
(E.D.M.)

Signed by Carl P. Englert Jr. Date 12/6/93
Surveyor's Michigan License No. 18987

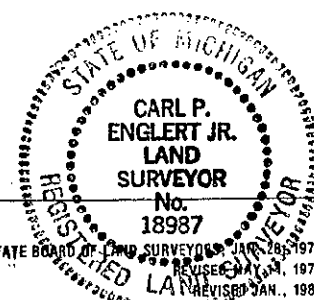

FORM APPROVED BY MICHIGAN STATE BOARD OF LAND SURVEYORS JAN. 28, 197
REVISION JAN. 197