

DEC 01 1998

SECTION

OTTAWA COUNTY REMONUMENTATION
LAND CORNER RECORDATION CERTIFICATE
Filing Requirement of Act 74, Mich. P.A. 1970

For corners in

Ottawa
(County)

Located in: Robinson Twp. Corner Code # L-1

- | | | |
|------------------------------------|----------------------------|------------------------|
| 1. Public Land Survey | T <u>7</u> N R <u>15</u> W | N1/4 Corner |
| | T _____ R _____ | of Section 1 |
| | T _____ R _____ | |
| | T <u>8N</u> R <u>15W</u> | <u>L-13</u> |
| 2. Property Controlling in Section | S _____ T _____ R _____ | |
| | S _____ T _____ R _____ | |
| 3. Miscellaneous Property in Sec. | S _____ T _____ R _____ | COMMON CORNER TO |
| | S _____ T _____ R _____ | <u>L-13, T8N, R15W</u> |

RECORDED

98 JUL 24 PM 1:45

Sam Schaller
REGISTER OF DEEDS
OTTAWA COUNTY, MI

Register of Deeds Stamp & File Number

4. Lot No. _____, Recorded Plat _____
5. Private Claims _____

I, Robert E. Lemke, in a field survey on November 17, 1997 do hereby state that under requirements of P.A. 74, Michigan P.A. of 1970, the corner points mentioned in lines 1 and 2 above were in conformance with regulations and rules therefore as required in the current manual of survey instructions of the United States Department of the Interior, Bureau of Land Management or by a decree of a Court of Law and /or that the corner points mentioned in lines 3, 4 and 5 above were in conformance with the rules of the Michigan Board of Land Surveyors or by a Decree of a Court of Law; established, re-established, monumented, recovered, found as expressed below:

1	A	B	C	D	E	F	G	H	I	J	K	L	M
2		6		5		4		3		2		1	
3													
4		7		8		9		10		11		12	
5													
6		18		17		16		15		14		13	
7													
8		19		20		21		22		23		24	
9													
10		30		29		28		27		26		25	
11													
12		31		32		33		34		35		36	
13													

NOTE: Not more than 2 corners, all in the same town and range, may be recorded on this certificate.

A. Description of original monument and accessories and/or subsequent restoration:

- | | | | |
|---|---|--|---|
| L-1
Not set by GLO | Witness Card From Holland Engineering
3/4" Pipe JKA 73
N bank Grand River S 30' +/-
16" Twin Ash WNW 54.22
24" Maple NW 106.92'
16" Trip Maple NNE 41.70'
24" Ash SE 23.10' | LCRC L2-P75
By John Clapp(Mar. 73),
PS 14091
Same 3/4" pipe and witnesses as
1973 Witness card | Act 132 Survey
9/13/72 by C. Englert
L-1 not shown,
However angle of
90°20'10" can be calc. |
| Act 132 Survey
5/22/75 by Van Kooten
L-1 not shown
However angle of
90°20'00" can be calculated | "Note this iron is not
the true 1/4 corner." | | |


RA. 845 OTTAWA COUNTY
PEER APPROVED 4-20-98
ADP

B. Description of corner evidence found and/or method applied in restoring or reestablishing corner:
L-1- The corner recorded in LCRC L2-P75 is likely a meander corner set in the 1975 survey by Van Kooten and should not have been recorded as the section corner. Found. 1/2" steel bar. Fence to North & South. The angle between the section line as defined by the 1/2" steel bar and the East line of the S.E. 1/4 of Section 36, T8N-R15W matches the angle on surveys recorded in L1-P513 and L2-P471 and as verbally confirmed from the records of Don Schiele, PS(Don's records show an angle of 90°20'10"). The found corner falls 5.80 feet North of a straight line between K-1 and M-1. Replaced 1/2" steel bar with Ottawa County Remonumentation Iron(3/4" by 36" with 2" cap). Accepted as common corner between Robinson and Crockery Township.

C. Description of monument for corner and accessories established to perpetuate locating the position of the corner:

- L-1-
Ottawa County Remonumentation Iron(3/4" by 36" with 2" cap).
Set nail & tag, W. side 8" Ash, 1' above ground, N 15° E 24.30 ft.
Set nail & tag, N. side, 10" Ash, 2.0' above ground N 65° E 26.80 ft.
Set nail & tag, NE side, 6" Ash, 0.7' above ground S 35° E 30.75 ft.
Set nail & tag, E side, 12" Ash, 1.0' above ground S 00° E 6.39 ft.
Found 3/4"(od) pipe N 3°W 1.02'
L-1 to K-1 measures 2648.64' and L-1 to M-1 measures 2665.21' with an angle on the North side at L-1 of 180°15'01". Back sight is K-1 and the foresight is M-1.

Signed by *Robert E. Lemke*
Surveyor's Michigan License No. 40160 for SDI Consultants LTD.

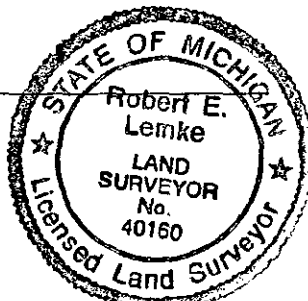


Date 5/15/98

FORM APPROVED BY MICHIGAN STATE BOA
OF PROFESSIONAL SURVEYORS. JAN. 28, 19
REVISED MAY 14, 19
REVISED JAN., 19
REVISED OCT., 19

SURVEY &
REMONUMENTATION

DEC 01 1998

SECTION

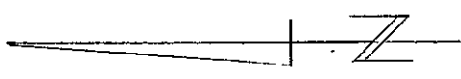

S 1/4 SEC. 36
T. 8N R. 15W



SEC. COR. SEC. 36
T. 8N R. 15W
M13

2665.21 FT.

COMMON CORNER

M1

NE COR. SEC. 1
T. 7N R. 15W

COMMON CORNER

5.80 FT.

2648.64 FT.

SW COR. SEC. 36
T. 8N R. 15W
K13

COMMON CORNER

K1

N 1/4 SEC. 1
T. 7N R. 15W

NW COR. SEC. 1
T. 7N R. 15W