

**SURVEY &
REMONUMENTATION**

DEC 1 6 1998

COMMISSION

**OTTAWA COUNTY REMONUMENTATION
LAND CORNER RECORDATION CERTIFICATE
Filing Requirement of Act 74, Mich. P.A. 1970**

For corners in

<u>Ottawa</u> (County)	Located In:	Corner Code #
	Robinson Township	
1. Public Land Survey	T <u>7</u> N R <u>15</u> W	L-3
	T ___ R ___	North $\frac{1}{4}$ corner
	T ___ R ___	Section 12
	T ___ R ___	
2. Property Controlling in Section	S ___ T ___ R ___	
	S ___ T ___ R ___	
3. Miscellaneous Property in Sec.	S ___ T ___ R ___	
	S ___ T ___ R ___	

RECORDED

95 NOV 14 AM 11:21

Phyllis Robinson
REGISTER OF DEEDS
OTTAWA COUNTY, MI

Register of Deeds Stamp & File Number

4. Lot No. _____, Recorded Plat _____
5. Private Claims _____

I, Carl P. Englert, in a field survey on 9/12, 19 96 do hereby state that under requirements of P.A. 74, Michigan P.A. of 1970, the corner points mentioned in lines 1 and 2 above were in conformance with regulations and rules therefore as required in the current manual of survey instructions of the United States Department of the Interior, Bureau of Land Management or by a decree of a Court of Law and/or that the corner points mentioned in lines 3, 4 and 5 above were in conformance with the rules of the Michigan Board of Land Surveyors or by a Decree of a Court of Law; established, re-established, monumented, recovered, found as expressed below:

NOTE: Not more than 2 corners, all in the same town and range, may be recorded on this certificate.

	A	B	C	D	E	F	G	H	I	J	K	L	M
1													
2	6		5		4		3		2		1		
3													12
4	7		8		9		10		11		12		
5													
6	18		17		16		15		14		13		
7													
8	19		20		21		22		23		24		
9													
10	30		29		28		27		26		25		
11													
12	31		32		33		34		35		36		
13													

A. Description of original monument and accessories and/or subsequent restoration:

L-3 1/4 corner common to Sections 1 & 12	LCRC Liber 1, Page 659
G.L.O. May 1832 by Calvin Britain	October 1972
Set 1/4 Section Post on true line	Found Iron Bar & Angle Iron
W. Ash 12" S68°E 26 links	14" Oak N3°E 14.20'
Beech 12" N68°W 34 links	14" Oak S47°E 29.80'
	Fence Cor. S12°E 26.75'
	30" Oak S47°W 53.00'
See Other Side	

B. Description of corner evidence found and/or method applied in restoring or reestablishing corner:


L-3 1/4 corner common to Sections 1 & 12
Found Cast Iron Monument
Found 15" Oak S 26.73'
Found 30" Stump S.W. 53'±
Found 18" Oak N. 14.42'
Found 16" Oak S.E. 29.79'

P.A. 345 OTTAWA COUNTY
PEER APPROVED 9-16-96
J.P.D.

Accepted as a careful and faithful perpetuation of the original position of the corner.

C. Description of monument for corner and accessories established to perpetuate locating the position of the corner:

L-3 1/4 corner common to Sections 1 & 12
4" Harrison Cast Iron Monument
O.C. Remon tag & nail in W. side 18" Oak South 26.68'
O.C. Remon tag & nail in S.W. side 18" Oak S45°E 29.82'
O.C. Remon tag & nail in N. side 11" Oak S70°W 13.06'
O.C. Remon tag & nail in E. side 18" Oak N3°E 14.32'
O.C. Remon tag & nail in S. side 6" Oak East 18.31'

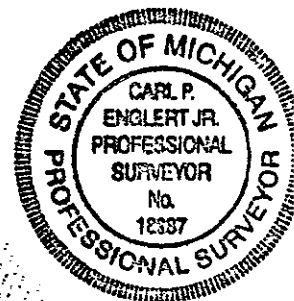

Signed by Carl P. Englert Jr.
Surveyor's Michigan License No. 18337

Date 9/16/1996

SURVEY &
REMONUMENTATION

DEC 16 1996

COMMISSION

L-3 1/4 corner common to Sections 1 & 12 T7N, R15W
LCRC Liber 5, Page 249 August 1986
Found Iron Bar and Angle Iron Set CIM
18" Oak N. 14.42'
15" Oak S. 26.73'
16" Oak S.E. 29.79'
30" Stump S.W. 53.04'