

DEC 05 2000

SECTION

OTTAWA COUNTY REMONUMENTATION LAND CORNER RECORDATION CERTIFICATE Filing Requirement of Act 74, Mich. P.A. 1970

RECORDED

97 DEC -8 AM 11:42

Handwritten signature and REGISTER OF DEEDS OTTAWA COUNTY, MI

Register of Deeds Stamp & File Number

For corners in

Ottawa (County)

Located In: Corner Code # Robinson Township

- 1. Public Land Survey T 7N R 15W L-13 South 1/4 corner Section 36
2. Property Controlling in Section S T R
3. Miscellaneous Property in Sec. S T R

- 4. Lot No. Recorded Plat
5. Private Claims

I, Carl P. Englert, in a field survey on 6/10, 1997 do hereby state that under requirements of P.A. 74, Michigan P.A. of 1970, the corner points mentioned in lines 1 and 2 above were in conformance with regulations and rules therefore as required in the current manual of survey instructions of the United States Department of the Interior, Bureau of Land Management or by a decree of a Court of Law and for that the corner points mentioned in lines 3, 4 and 5 above were in conformance with the rules of the Michigan Board of Land Surveyors or by a Decree of a Court of Law; established, re-established, monumented, recovered, found as expressed below:

NOTE: Not more than 2 corners, all in the same town and range, may be recorded on this certificate.

Grid table with columns A-M and rows 1-13, containing numbers 1-36.

A. Description of original monument and accessories and/or subsequent restoration:

L-13 South 1/4 corner Section 36 G.L.O. 1832 Sylvester Sibley Set 1/4 Post Hemlock 6" N82°E 32 links Hemlock 5" N 3°E 33 links

LCRC Liber 6, Page 136 3/27/91 Found Cast Iron Monument, no recorded ties Monument is midway between Section corners Reset Monument West 46.48' to Olive Corner N50°W 51.70' Nail SW side 12" Pine N45°W 48.60' Nail SE side 12" Elm S40°E 47.76' Nail N side 6" Tree S40°W 29.70' Nail NW side Tw. 18" Oak

B. Description of corner evidence found and/or method applied in restoring or reestablishing corner:


L-13 South 1/4 corner Section 36 Found 4" Cast Iron Mon. in Mon. Box Found T6N, R15W corner West 46.43' Found Tw. 18" Oak S40°W 29.70'

P.A. 345 OTTAWA COUNTY PEER APPROVED 12-1-97 Handwritten signature

Accepted as a careful and faithful perpetuation of the original position of the corner.

C. Description of monument for corner and accessories established to perpetuate locating the position of the corner:

L-13 South 1/4 corner Section 36 4" Harrison Cast Iron Monument in Mon. Box on centerline of Road O.C. Remon Tag & Nail in NW Side 20" Tw. Oak S32°W 30.12' O.C. Remon Tag & Nail in SE Side 6" Ash S53°E 48.76' O.C. Remon Tag & Nail in S Side 7" Ash N77°E 107.15' O.C. Remon Tag & Nail in E Side 16" Pine N55°W 51.10' T6N, R15W corner West 46.43'

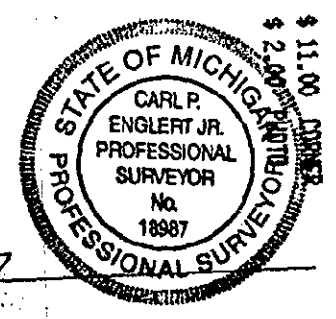


Signed by Carl P. Englert Surveyor's Michigan License No. 18987

Date 12/1/1997

L-13 FOUND CAST IRON MON. IN MON. BOX

ROBINSON T.W.P.  
T. 7 N. R. 15 W.

OLIVE T.W.P.  
T. 6 N. R. 15 W.

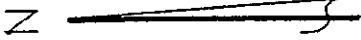

NO SCALE

SURVEY &  
REMONUMENTATION

FEB 27 1998

SECTION

