

**OTTAWA COUNTY REMONUMENTATION
LAND CORNER RECORDATION CERTIFICATE
Filing Requirement of Act 74, Mich. P.A. 1970**

RECORDED

96 DEC 18 PM 4:56

Richard Robinson
REGISTER OF DEEDS
OTTAWA COUNTY, MI

For corners in

<u>Ottawa</u> (County)	Located In: Robinson Twp.	Corner Code # M-1
1. Public Land Survey	T <u>7N</u> R <u>15W</u>	<u>NE corner</u>
	T ___ R ___	<u>Section 1</u>
	T ___ R ___	<u>Common corner</u>
2. Property Controlling in Section	S ___ T ___ R ___	<u>to M-13 Crockery</u>
3. Miscellaneous Property in Sec.	S ___ T ___ R ___	<u>Twp. _____</u>

Register of Deeds Stamp & File Number

4. Lot No. _____, Recorded Plat _____
5. Private Claims _____

A	B	C	D	E	F	G	H	I	J	K	L	M
1												
2	6	5	4	3	2	1						
3												
4	7	8	9	10	11	12						
5												
6	18	17	16	15	14	13						
7												
8	19	20	21	22	23	24						
9												
10	30	29	28	27	26	25						
11												
12	31	32	33	34	35	36						
13												

I, Carl P. Englert, in a field survey on 9/3, 1996 do hereby state that under requirements of P.A. 74, Michigan P.A. of 1970, the corner points mentioned in lines 1 and 2 above were in conformance with regulations and rules therefore as required in the current manual of survey instructions of the United States Department of the Interior, Bureau of Land Management or by a decree of a Court of Law and/or that the corner points mentioned in lines 3, 4 and 5 above were in conformance with the rules of the Michigan Board of Land Surveyors or by a Decree of a Court of Law; established, re-established, monumented, recovered, found as expressed below:

NOTE: Not more than 2 corners, all in the same town and range, may be recorded on this certificate.

A. Description of original monument and accessories and/or subsequent restoration:

M-1 N.E. Corner Section 1	LCRC Liber 1, Page 637 Sept. 1972
G.L.O. 1837 by John Mullett	Found Concrete Monument
Set Post Corner Towns 7 & 8 North	S.W. 12.67' 14" Pine
and Ranges 14 & 15 West	S.E. 14.47' 18" Pine
Pine 20" dia. bears S52°E 7 links	N.E. 27.46' 4" Cherry
Hemlock 10" bears N82°W 24 links	

See Other Side

B. Description of corner evidence found and/or method applied in restoring or reestablishing corner:

M-1 N.E. Cor. Section 1
Found Cast Iron Monument
Found S.W. 12.67' 14" Pine
Found S.E. 14.47' 8" Pine
Found N.E. 27.46' 4" Cherry

P.A. 345 OTTAWA COUNTY
PEER APPROVED 12-9-96

C.P.E.

Accepted as a careful and faithful perpetuation of the original position of the corner.


C. Description of monument for corner and accessories established to perpetuate locating the position of the corner:

M-1 N.E. Corner Section 1
4" Harrison Cast Iron Monument 1" deep

O.C. Remon tag & nail in E. Side 18" Pine	S25°W 12.49'
O.C. Remon tag & nail in N. Side 12" Spruce	S88°E 19.73'
O.C. Remon tag & nail in E. Side 12" Cherry	N20°E 27.39'
O.C. Remon tag & nail in N.E. Side Tw. 8" Pine	N50°W 24.50'

Signed by Carl P. Englert Jr.

Date 11/23/96

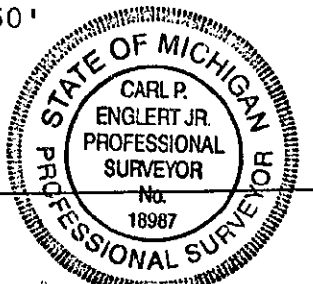

M-13 Section corner common to Section 31, T8N, R14W, Section 36, T8N,
R15W, Section 1, T7N, R15W & Section 6, T7N, R14W

LCRC Liber 4, Page 232 Oct. 1981

Set Cast Iron Monument
8" Pine S.E. 14.52'
16" Pine S.W. 12.57'
6" Cherry N.N.E. 27.43'
8" Spruce E.N.E. 22.5'

LCRC Liber 5, Page 317 May 1988

Found C.I. Monument
Found Spike in E. Side 16" Pine S.W. 12.6'
Found Spike in N.E. Side 4" Pine S.E. 14.49'
Found Spike in E. Side 6" W. Cherry N.N.E. 27.44'
Found Spike in S. Side 8" Spruce E.N.E. 22.49'