

**SURVEY & REMONUMENTATION**

APR 24 1995

**OTTAWA COUNTY REMONUMENTATION LAND CORNER RECORDATION CERTIFICATE**  
 Filing Requirement of Act 74, Mich. P.A. 1970

RECORDED

94 DEC 15 AM 11:52

COMMISSION

For corners in

<u>Ottawa</u> (County)	Located In: <u>Robinson Twp.</u>	Corner Code # <u>M-5</u>
1. Public Land Survey	T <u>7N</u> R <u>15W</u>	<u>N.E. Corner</u> <u>Section 13</u>
	T ___ R ___	_____
	T ___ R ___	_____
	T ___ R ___	_____
2. Property Controlling in Section	S ___ T ___ R ___	_____
	S ___ T ___ R ___	_____
3. Miscellaneous Property in Sec.	S ___ T ___ R ___	_____
	S ___ T ___ R ___	_____

*Reginald C. ...*  
 REGISTER OF DEEDS  
 OTTAWA COUNTY, MI

Register of Deeds Stamp & File Number

4. Lot No. \_\_\_\_\_, Recorded Plat \_\_\_\_\_  
 5. Private Claims \_\_\_\_\_

A	B	C	D	E	F	G	H	I	J	K	L	M
2	6	5	4	3	2	1						
3												
4	7	8	9	10	11	12						
5												
6	18	17	16	15	14	13						
7												
8	19	20	21	22	23	24						
9												
10	30	29	28	27	26	25						
11												
12	31	32	33	34	35	36						
13												

I, Carl P. Englert in a field survey on November 22, 19 94, do hereby certify that under requirements of P.A. 74, Michigan P.A. of 1970, the corner points mentioned in lines 1 and 2 above were in conformance with regulations and rules therefore as required in the current manual of survey instructions of the United States Department of the Interior, Bureau of Land Management or by a decree of a Court of Law and/or that the corner points mentioned in lines 3, 4 and 5 above were in conformance with the rules of the Michigan Board of Land Surveyors or by a Decree of a Court of Law; established, re-established, monumented, re-monumented, recovered, found as expressed below:

**NOTE: Not more than 4 corners, all in the same town and range, may be recorded on this certificate.**

A. Description of original monument and accessories and/or subsequent restoration:  
 M-5 corner common to Sections 12 & 13  
 Original gov't corner set May 1832  
 by Calvin Britain D.S.

L.C.R.C. Liber 5, Page 249  
 M-5 1 1/2" Pipe  
 40" Maple S.E. 5.17'  
 16" Cherry Stump N.W. 31.01'  
 Power Pole E.N.E. 94.72'  
 N.E. Cor. Hse #9612 S.W. 86.88'

See Back of Page

B. Description of corner evidence found and/or method applied in restoring or reestablishing corner:


M-5 corner common to Sections 12 & 13  
 Found 4" Harrison Cast Iron Mon. at Ground Level  
 Found N.E. Cor. Hse. S.W. 86.87'  
 Found 36" Maple S.E. 5.17'  
 Found P.P. E.N.E. 94.72'  
 Found 16" Cherry N.W. 31.01'

PA 245 OTTAWA COUNTY  
 PA 245 APPROVED 12/12/94  
*Handwritten signature*

Accepted as a careful and faithful perpetuation of the position of the original corner.

C. Description of monument for corner and accessories established to perpetuate locating the position of the corner:

M-5 corner common to Sections 12 & 13.  
 4" Harrison Cast Iron Mon.  
 O.C. Remon. Tag & Nail in N. side P.P. N84°E 94.83'  
 O.C. Remon. Tag & Nail in N. side 40" Maple S51°E 5.30'  
 O.C. Remon. Tag & Nail in N.E. Side 16" Cherry N32°W 30.68'  
 N.E. corner of House Foundation S37°W 86.84'  
 Allendale corner South 52.58'

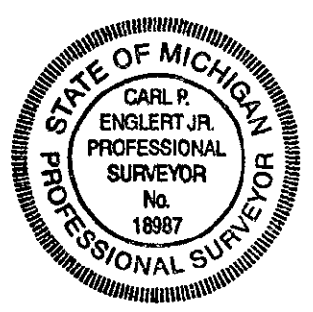

Signed by Carl P. Englert Jr. Date 12/1/94  
 Surveyor's Michigan License No. 18987

L.C.R.C. Liber 2, Page 637  
M-5 1 1/2" Pipe (Found)

S.E. 40" Maple 5.17'  
N.W. 31.05' 16" Cherry  
E.N.E. 94.70' P.P.

L.C.R.C. Liber 4, Page 92  
M-5

Set C.I.M.	
Cherry Stump	N.W. 31.00'
N.E. cor. Hse.	S.W. 86.87'
36" Maple	S.E. 5.49'
Allendale Cor.	S. 52.58'