

SURVEY & REMONUMENTATION

APR 05 1996

COMMISSION

**OTTAWA COUNTY REMONUMENTATION
LAND CORNER RECORDATION CERTIFICATE
Filing Requirement of Act 74, Mich. P.A. 1970**

For corners in

Ottawa (County)	Located In:	Corner Code #
1. Public Land Survey	T <u>7N</u> R <u>16W</u>	E-1, NE corner Section 5 Grand Haven Twp
	T _____ R _____	_____
	T _____ R _____	_____
	T _____ R _____	_____
2. Property Controlling in Section	S _____ T _____ R _____	_____
	S _____ T _____ R _____	_____
3. Miscellaneous Property in Sec.	S _____ T _____ R _____	_____
	S _____ T _____ R _____	_____

RECORDED

95 NOV 29 PM 1:40

Richard L. Anderson
REGISTER OF DEEDS
OTTAWA COUNTY, MI

Register of Deeds Stamp & File Number

4. Lot No. _____, Recorded Plat _____
5. Private Claims _____

	A	B	C	D	E	F	G	H	I	J	K	L
2	6	5			4			3		2		
3												
4	7	8			9			10		11		12
5												
6	10	17			16			15		14		13
7												
8	19	20			21			22		23		24
9												
10	30	29			28			27		26		25
11												
12	31	32			33			34		35		36
13												

I, Thomas E. Joiner, in a field survey on 11/7, 19 95, do hereby certify that under requirements of P.A. 74, Michigan P.A. of 1970, the corner points mentioned in lines 1 and 2 above were in conformance with regulations and rules therefore as required in the current manual of survey instructions of the United States Department of the Interior, Bureau of Land Management or by a decree of a Court of Law and/or that the corner points mentioned in lines 3, 4 and 5 above were in conformance with the rules of the Michigan Board of Land Surveyors or by a Decree of a Court of Law; established, re-established, monumented, re-monumented, recovered, found as expressed below:

NOTE: Not more than 4 corners, all in the same town and range, may be recorded on this certificate.

A. Description of original monument and accessories and/or subsequent restoration:

05-1832	Liber 1, Page 61	09-20-71
Post Set By Calvin Britain, D.S.	Found 3" Iron Pipe	
12" Beech is Post	5" Pine	WSW 11.32
	5" Pine	NW 13.28
	3" Cherry	NNE 7.62
	5" Pine	NE 16.60
	SE cor. of Sec. 32, T8N, R16W	E 75.24

B. Description of corner evidence found and/or method applied in restoring or reestablishing corner:
Found Cast Iron Monument in Monument Box and accepted as a careful and faithful perpetuation of the position of the original corner.

Liber 1, Page 61
SE cor. of Section 32, T8N, R16W East 75.24


P.A. 345 OTTAWA COUNTY
PEER APPROVED 11/20/95

Richard D. Hedewald
RDH

C. Description of monument for corner and accessories established to perpetuate locating the position of the corner:

Cast Iron Monument

SE cor. of Section 32, T8N, R16W	AZ	90°	75.24
SW cor. of House Foundation	AZ	60°	27.85
NW cor. of House Foundation	AZ	12°	76.65
O.C. Remon Tag & Nail in SW side Jack Pine	AZ	302°	28.77
O.C. Remon Tag & Nail in W side Wild Cherry	AZ	172°	13.90

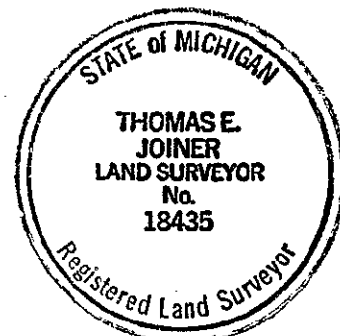

Signed by Thomas E. Joiner Date 11-16-95
Surveyor's Michigan License No. 18435