

APR 05 1996

COMMISSION

OTTAWA COUNTY REMONUMENTATION
LAND CORNER RECORDATION CERTIFICATE
Filing Requirement of Act 74, Mich. P.A. 1970

For corners in

Ottawa (County)	Located In:	Corner Code #
1. Public Land Survey	T 7N R 16W	E-4, E 1/4 corner Section 8 Grand Haven Twp
	T _____ R _____	_____
	T _____ R _____	_____
	T _____ R _____	_____
2. Property Controlling in Section	S _____ T _____ R _____	_____
	S _____ T _____ R _____	_____
3. Miscellaneous Property in Sec.	S _____ T _____ R _____	_____
	S _____ T _____ R _____	_____
4. Lot No. _____, Recorded Plat _____		
5. Private Claims _____		

RECORDED

95 NOV 29 PM 1:40

Robert S. ...
REGISTER OF DEEDS
OTTAWA COUNTY, MI

Register of Deeds Stamp & File Number

I, THOMAS E. JOINER, in a field survey on 11-7-, 19 95, do hereby certify that under requirements of P.A. 74, Michigan P.A. of 1970, the corner points mentioned in lines 1 and 2 above were in conformance with regulations and rules therefore as required in the current manual of survey instructions of the United States Department of the Interior, Bureau of Land Management or by a decree of a Court of Law and/or that the corner points mentioned in lines 3, 4 and 5 above were in conformance with the rules of the Michigan Board of Land Surveyors or by a Decree of a Court of Law; established, re-established, monumented, re-monumented, recovered, found as expressed below:

NOTE: Not more than 4 corners, all in the same town and range, may be recorded on this certificate.

A. Description of original monument and accessories and/or subsequent restoration:

05-24-1832	Liber 1, Page 373	05-11-72	Liber 4, Page 52	04-14-80
Post Set By Calving Britain, D.S.	Found Conc. Block		Found 1" Angle Iron	
S 29° E 29 8" Beech	Set 1" Angle Iron		Set Cast Iron Monument	
N 40° W 15 6" Beech	N 2° E 24.09 12" Oak		NNE 23.94 13" Twin Red Oak	
	N 85° W 16.21 20" Twin Cherry		SE 18.24 18" Twin Beech	
	S 45° E 18.18 15" Twin Beech		WNW 16.20 18" Twin Black Cher	
	S 29.0 24" Oak Stump		WSW 41.80 12" Red Oak	
			SW 11.83 13" Beech	

B. Description of corner evidence found and/or method applied in restoring or reestablishing corner:

Found Cast Iron Monument in Monument Box and accepted as a careful and faithful perpetuation of the position of the original corner.

Liber 4, Page 52 04-14-80

NNE 23.94 13" Twin Red Oak
SE 18.24 18" Twin Beech
WNW 16.20 18" Twin Black Cherry
WSW 41.80 12" Red Oak
SW 11.83 13" Beech


P.A. 345 OTTAWA COUNTY
PEER APPROVED 11/20/95

Robert S. ...
TDN

C. Description of monument for corner and accessories established to perpetuate locating the position of the corner:

Cast Iron Monument

O.C. Remon Tag & Nail in E side 15" Beech	AZ.	209°	12.68
O.C. Remon Tag & Nail in S side 15" Oak	AZ.	254°	42.58
O.C. Remon Tag & Nail in NE side Twin 20" Beech	AZ.	128°	19.78
O.C. Remon Tag & Nail in E side Twin 12" Oak	AZ.	10°	26.13

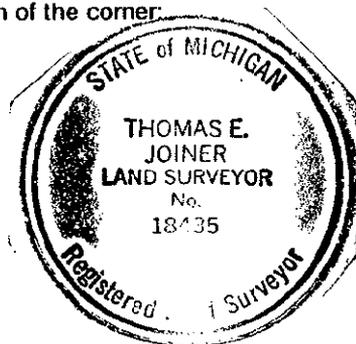

Signed by Thomas E. Joiner Date 11-16-95
Surveyor's Michigan License No. 18435