

**SURVEY & REMONUMENTATION**

APR 24 1995

**OTTAWA COUNTY REMONUMENTATION  
LAND CORNER RECORDATION CERTIFICATE**  
Filing Requirement of Act 74, Mich. P.A. 1970

RECORDED


94 DEC 14 AM 9:40

For corners in **COMMISSION**

*Dorothy Robinson*  
REGISTER OF DEEDS  
OTTAWA COUNTY, MI

OTTAWA (County)	Located In:	Corner Code #
1. Public Land Survey	T 7N R 16W	E-5, SE Corner Section 8 Grand Haven Twp.
	T _____ R _____	_____
	T _____ R _____	_____
	T _____ R _____	_____
2. Property Controlling in Section	S _____ T _____ R _____	_____
	S _____ T _____ R _____	_____
3. Miscellaneous Property in Sec.	S _____ T _____ R _____	_____
	S _____ T _____ R _____	_____
4. Lot No. _____, Recorded Plat _____		
5. Private Claims _____		

Register of Deeds Stamp & File Number

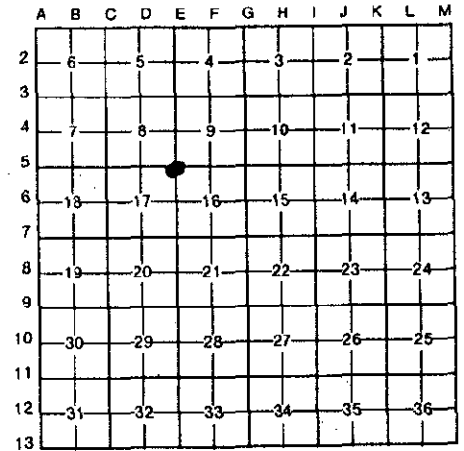

I, THOMAS E. JOINER in a field survey on 10-26- 1994, do hereby certify that under requirements of P.A. 74, Michigan P.A. of 1970, the corner points mentioned in lines 1 and 2 above were in conformance with regulations and rules therefore as required in the current manual of survey instructions of the United States Department of the Interior, Bureau of Land Management or by a decree of a Court of Law and/or that the corner points mentioned in lines 3, 4 and 5 above were in conformance with the rules of the Michigan Board of Land Surveyors or by a Decree of a Court of Law; established, re-established, monumented, re-monumented, recovered, found as expressed below:

**NOTE: Not more than 4 corners, all in the same town and range, may be recorded on this certificate.**

A. Description of original monument and accessories and/or subsequent restoration:  
 05-24-1832 Liber 1, Pg. 681, 10-13-72  
 Post set by Calvin Britain, D.S. Found cast iron monument  
 N62°W 19 12" Pine N23°W 10.39 Nail in face 8" Spruce  
 N15°E 26 15" Pine N35°E 6.86 Nail in face 6" Spruce  
 S06°E 14.64 Nail in face 8" Maple

Liber 1, Pg. 219, 01-10-71  
 Found 1" iron  
 S05°E 14.60 8" Maple  
 N40°E 6.90 6" Hemlock  
 N45°W 10.40 10" Hemlock  
 Liber 1, Pg. 151, 11-23-71  
 Set cast iron monument  
 N23° W 10.38 8" Spruce  
 N35°E 6.86 8" Spruce  
 S06°E 14.64 8" Maple

B. Description of corner evidence found and/or method applied in restoring or reestablishing corner:

Found cast iron monument and accepted as a careful and faithful perpetuation of the position of the original corner.

Liber 1, Pg. 681, 10-13-72  
 N 23° W 10.39 Nail in face of 8" Spruce  
 N 35° E 6.86 Nail in face of 6" Spruce  
 S 06° E 14.64 Nail in face of 8" Maple


Liber 1, Pg. 219, 01-10-72  
 S 05° E 14.60 8" Maple  
 N 40° E 6.90 6" Hemlock  
 N 45° W 10.40 10" Hemlock

Liber 1, Pg. 151, 11-23-71  
 N 23° W 10.38 8" Spruce  
 N 40° E 6.86 8" Spruce  
 S 06° E 14.64 8" Maple

C. Description of monument for corner and accessories established to perpetuate locating the position of the corner:

Cast Iron Monument

O.C. Remon. Tag & Nail in S side 7" Hemlock	Az. 35° 7.40
O.C. Remon. Tag & Nail in S side 12" Maple	Az. 171° 15.22
O.C. Remon. Tag & Nail in S side 20" Oak	Az. 282° 25.93
O.C. Remon. Tag & Nail in E side 16" Oak	Az. 305° 16.16

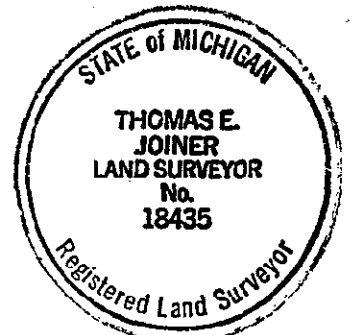

P.A. 345 OTTAWA COUNTY

PEER APPROVED 12/12/94

Signed by Thomas E. Joiner Date 11-28-94  
 Surveyor's Michigan License No. 18435

FORM APPROVED BY MICHIGAN STATE BOARD OF LAND SURVEYORS, JAN. 28, 1971  
 REVISED MAY 14, 1975  
 REVISED JAN., 1983