

**OTTAWA COUNTY REMONUMENTATION
LAND CORNER RECORDATION CERTIFICATE
Filing Requirement of Act 74, Mich. P.A. 1970**

RECORDED

94 DEC 14 AM 9:40

For corners in

<u>Ottawa</u> <small>(County)</small>	Located In:	Corner Code #
1. Public Land Survey	T <u>7N</u> R <u>16W</u>	E-6, W $\frac{1}{2}$ corn.
	T _____ R _____	Section 16
	T _____ R _____	Grand Haven Twp
	T _____ R _____	
2. Property Controlling in Section	S _____ T _____ R _____	
	S _____ T _____ R _____	
3. Miscellaneous Property in Sec.	S _____ T _____ R _____	
	S _____ T _____ R _____	
4. Lot No. _____, Recorded Plat _____		
5. Private Claims _____		

Robert Robinson
REGISTER OF DEEDS
OTTAWA COUNTY, MI

**SURVEY &
REMONUMENTATION**

DEC 05 2000

Register of Deeds Stamp & File Number

I, THOMAS E. JOINER, in a field survey on 10-13-99, do hereby certify that under requirements of P.A. 74, Michigan P.A. of 1970, the corner points mentioned in lines 1 and 2 above were in conformance with regulations and rules therefore as required in the current manual of survey instructions of the United States Department of the Interior, Bureau of Land Management or by a decree of a Court of Law and/or that the corner points mentioned in lines 3, 4 and 5 above were in conformance with the rules of the Michigan Board of Land Surveyors or by a Decree of a Court of Law; established, re-established, monumented, re-monumented, recovered, found as expressed below:

A	B	C	D	E	F	G	H	I	J	K	L	M
2	6	5	4	3	2	1						
3												
4	7	8	9	10	11	12						
5												
6	16	17	16	15	14	13						
7												
8	19	20	21	22	23	24						
9												
10	30	29	28	27	26	25						
11												
12	31	32	33	34	35	36						
13												

NOTE: Not more than 4 corners, all in the same town and range, may be recorded on this certificate.

A. Description of original monument and accessories and/or subsequent restoration:

05-24-1832	Liber 1, Pg. 681, 10-13-72	Liber 1, Pg. 219, 01-10-72
Post set by Calvin Britain, D.S.	Found Iron Pipe	Found 1" Iron
N 35° E 18 10" Red Oak	N 15° E 7.64 Nail in face of 22" Beech	N 22° E 7.65 18" Beech
S 65° W 15 12" Red Oak	N 45° E 13.63 Nail in face of 24" Oak	S 40° E 19.04 14" Oak
Liber 4, Pg. 15, 12-11-79	S 70° E 26.97 Nail in face of 12" Oak	S 74° E 26.90 14" Maple
Set Cast Iron Monument	S 35° E 19.36 Nail in face of 14" Maple	East 34.00 Conc. Monument
NE 7.91 20" Beech		
NE 14.14 25" Red Oak Stump		
NW 22.32 11" Maple		
SW 19.24 12" Red Oak Stump; East 34.00 Conc. Monument		

B. Description of corner evidence found and/or method applied in restoring or reestablishing corner:

Found Cast Iron Monument and accepted as a careful and faithful perpetuation of the position of the original corner.


Liber 4, Pg. 15, 12-11-79	Liber 1, Pg. 681, 10-13-72
NE 7.91 20" Beech	N 15° E 7.64 Nail in face of 22" Beech
NE 14.14 25" Red Oak (stump)	N 45° E 13.63 Nail in face of 24" Oak (stump)
NW 22.32 11" Maple	S 70° E 26.97 Nail in face of 12" Oak
SW 19.24 12" Red Oak (stump)	S 35° E 19.36 Nail in face of 14" Maple
East 34.00 Concrete Monument	S 80° E 34.03 Conc. Monument

Liber 1, Pg. 219, 01-10-72
N 22° E 7.65 18" Beech
S 40° E 19.04 14" Oak
S 74° E 26.90 14" Maple
East 34.00 Conc. Monument

C. Description of monument for corner and accessories established to perpetuate locating the position of the corner:

Cast Iron Monument

O.C. Remon Tag & Nail in W side 24" Beech	Az. 27°	8.74
O.C. Remon Tag & Nail in SW side Twin 12" Maple	Az. 290°	22.75
O.C. Remon Tag & Nail in E side 21" Maple	Az. 144°	20.07
O.C. Remon Tag & Nail in E side 18" Oak	Az. 111°	27.81
N edge 9' Asphalt Private Drive	Az. 180°	27.00±

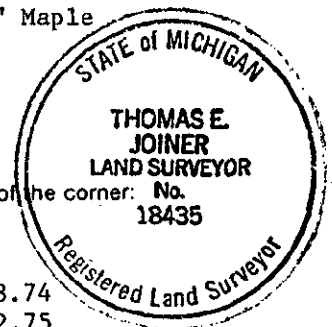

P.A. 345 OTTAWA COUNTY
DEED APPROVED 12/12/94

Signed by Thomas E. Joiner
Surveyor's Michigan License No. 18435

Date 11-21-94

FORM APPROVED BY MICHIGAN STATE BOARD OF LAND SURVEYORS, JAN. 26, 1971
REVISED MAY 14, 1975
REVISED JAN., 1983