

SURVEY & REMONUMENTATION

OCT 07 1996

COMMISSION

OTTAWA COUNTY REMONUMENTATION LAND CORNER RECORDATION CERTIFICATE Filing Requirement of Act 74, Mich. P.A. 1970

For corners in

Ottawa <small>(County)</small>	Located In:	Corner Code #/	
1. Public Land Survey	T <u>7</u> R <u>16</u>	F-3, S $\frac{1}{2}$ corner	
	T _____ R _____	Section 4	
	T _____ R _____	Grand Haven Twp	
	T _____ R _____		
2. Property Controlling in Section	S _____ T _____ R _____		
	S _____ T _____ R _____		
3. Miscellaneous Property in Sec.	S _____ T _____ R _____		
	S _____ T _____ R _____		

RECORDED

96 AUG 26 PM 2:01

Richard R. Hallock
REGISTER OF DEEDS
OTTAWA COUNTY, MI

Register of Deeds Stamp & File Number

4. Lot No. _____, Recorded Plat _____
5. Private Claims _____

	A	B	C	D	E	F	G	H	I	J	K	L	M
2	6	5	4	3	2	1							
3						●							
4	7	8	9	10	11	12							
5													
6	18	17	16	15	14	13							
7													
8	19	20	21	22	23	24							
9													
10	30	29	28	27	26	25							
11													
12	31	32	33	34	35	36							
13													

I, Thomas E. Joiner, in a field survey on January 24, 19 96, do hereby certify that under requirements of P.A. 74, Michigan P.A. of 1970, the corner points mentioned in lines 1 and 2 above were in conformance with regulations and rules therefore as required in the current manual of survey instructions of the United States Department of the Interior, Bureau of Land Management or by a decree of a Court of Law and/or that the corner points mentioned in lines 3, 4 and 5 above were in conformance with the rules of the Michigan Board of Land Surveyors or by a Decree of a Court of Law; established, re-established, monumented, re-monumented, recovered, found as expressed below:

NOTE: Not more than 4 corners, all in the same town and range, may be recorded on this certificate.

A. Description of original monument and accessories and/or subsequent restoration:

1837	Liber 5, Page 837 1-16-87	
Post Set by J. Mullet	Found Monument	
N 61° E 5' to 5" Hemlock	14" Oak SSE 23.60	
S 62° W 18' to 7" Beech	16" Oak SW 40.15	
	12" Pine N 10.25	
	10" Pine E 24.03	

Liber 6, Page 226 7-10-92	
Found 4" Diameter Conc. Monument	
6" White Pine N 66° E 24.03	
10" White Pine N 8° W 10.19	
16" Oak S 38° E 23.59	
14" Oak S 36° W 40.10	


B. Description of corner evidence found and/or method applied in restoring or reestablishing corner:

Found 4" square concrete monument and accepted as a careful and faithful perpetuation of the position of the original corner.

Concrete Monument
Liber 6, Page 225
14" Oak S 36° W 40.10

P.A. 345 OTTAWA COUNTY
PEER APPROVED 8-20-96

Richard P. Hedrick

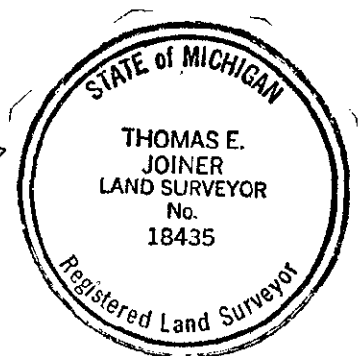

C. Description of monument for corner and accessories established to perpetuate locating the position of the corner:

Concrete Monument		
Ottawa County Remon tag and nail in S side 20" Oak	AZ 260°	49.98
Ottawa County Remon tag and nail in NE side 11" Oak	AZ 312°	15.58
Ottawa County Remon tag and nail in N side 12" Oak	AZ 82°	75.23
Ottawa County Remon tag and nail in SE side 18" Oak	AZ 216°	41.51

Signed by Thomas E. Joiner
Surveyor's Michigan License No. 18435

Date 2-16-96