

# SURVEY & REMONUMENTATION

APR 24 1995

COMMISSION

OTTAWA COUNTY REMONUMENTATION  
LAND CORNER RECORDATION CERTIFICATE  
Filing Requirement of Act 74, Mich. P.A. 1970

RECORDED

94 DEC 14 AM 9:40

*Joseph A. Kellerman*  
REGISTER OF DEEDS  
OTTAWA COUNTY, MI


For corners in

Ottawa <small>(County)</small>	Located In:	Corner Code $\neq$
1. Public Land Survey	T <u>7N</u> R <u>16W</u>	<u>F-9, S<math>\frac{1}{2}</math> Cor.</u> <u>Section 21</u> <u>Grand Haven Twp.</u>
	T _____ R _____	_____
	T _____ R _____	_____
	T _____ R _____	_____
2. Property Controlling in Section	S _____ T _____ R _____	_____
	S _____ T _____ R _____	_____
3. Miscellaneous Property in Sec.	S _____ T _____ R _____	_____
	S _____ T _____ R _____	_____
4. Lot No. _____, Recorded Plat _____		
5. Private Claims _____		

Register of Deeds Stamp & File Number

I, THOMAS E. JOINER in a field survey on 11-22-94, 19 94, do hereby certify that under requirements of P.A. 74, Michigan P.A. of 1970, the corner points mentioned in lines 1 and 2 above were in conformance with regulations and rules therefore as required in the current manual of survey instructions of the United States Department of the Interior, Bureau of Land Management or by a decree of a Court of Law and/or that the corner points mentioned in lines 3, 4 and 5 above were in conformance with the rules of the Michigan Board of Land Surveyors or by a Decree of a Court of Law; established, re-established, monumented, re-monumented, recovered, found as expressed below:

**NOTE: Not more than 4 corners, all in the same town and range, may be recorded on this certificate.**

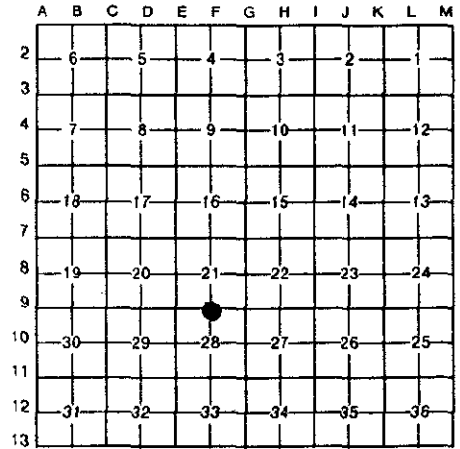

A. Description of original monument and accessories and/or subsequent restoration:

05-20-1832 Post Set by J. Mullet, D.S. 12" Birch is Post	Liber 2, Pg. 233, 06-25-73 Found "T" Iron South 49.60 Tel. Pole NW 52.0 Manhole South 1.00 $\text{\textcircled{C}}$ Pavement S45°E 42.74 8" Maple	Liber 4, Pg. 311, 04-14-82 Set Cast Iron Monument SE 41.72 10" Elm SW 54.53 10" Hemlock NW 44.31 10" Beech NE 59.87 9" Ash
----------------------------------------------------------------	---	---


B. Description of corner evidence found and/or method applied in restoring or reestablishing corner:

Found Cast Iron Monument in Monument Box and accepted as a careful and faithful perpetuation of the position of the original corner.

Liber 4, Pg. 311, 04-14-82  
SW 54.53 10" Hemlock  
NW 44.31 10" Beech  
NE 59.87 9" Ash

P.A. 345 OTTAWA COUNTY  
PEER APPROVED 12/12/94

*Madison D. Nedwell*

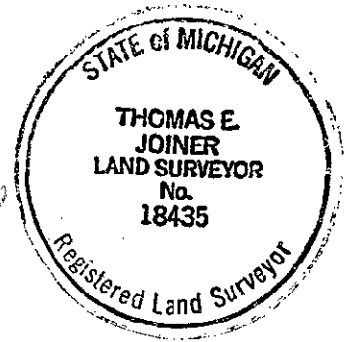

C. Description of monument for corner and accessories established to perpetuate locating the position of the corner:

Cast Iron Monument in Monument Box

O.C. Remon. Tag & Nail in SE side 12" Ash	Az. 42° 59.87
O.C. Remon. Tag & Nail in NE side 12" Aspen	Az. 130° 77.15
O.C. Remon. Tag & Nail in SE side 12" Hemlock	Az. 222° 54.23
O.C. Remon. Tag & Nail in SW side 14" Beech	Az. 338° 44.39

Signed by Thomas E. Joiner Date 12-12-94  
Surveyor's Michigan License No. 18435