

OTTAWA COUNTY REMONUMENTATION
LAND CORNER RECORDATION CERTIFICATE
 Filing Requirement of Act 74, Mich. P.A. 1970

RECORDED

97 JUL 24 PM 2:23

Deborah Anderson
 REGISTER OF DEEDS
 OTTAWA COUNTY, MI

For corners in

Ottawa (County)	Located In:	Corner Code #
1. Public Land Survey	T <u>7</u> R <u>16</u>	F-11, S $\frac{1}{2}$ corner Section 28 Grand Haven Twp
	T _____ R _____	_____
	T _____ R _____	_____
	T _____ R _____	_____
2. Property Controlling in Section	S _____ T _____ R _____	_____
	S _____ T _____ R _____	_____
3. Miscellaneous Property in Sec.	S _____ T _____ R _____	_____
	S _____ T _____ R _____	_____
4. Lot No. _____, Recorded Plat _____		
5. Private Claims _____		

**SURVEY &
 REMONUMENTATION**

DEC 05 2000

Register of Deeds Stamp & File Number
 SECTION

I, THOMAS E. JOINER in a field survey on November 26, 1996, do hereby certify that under requirements of P.A. 74, Michigan P.A. of 1970, the corner points mentioned in lines 1 and 2 above were in conformance with regulations and rules therefore as required in the current manual of survey instructions of the United States Department of the Interior, Bureau of Land Management or by a decree of a Court of Law and/or that the corner points mentioned in lines 3, 4 and 5 above were in conformance with the rules of the Michigan Board of Land Surveyors or by a Decree of a Court of Law; established, re-established, monumented, re-monumented, recovered, found as expressed below:

NOTE: Not more than 4 corners, all in the same town and range, may be recorded on this certificate.

	A	B	C	D	E	F	G	H	I	J	K	L	M
2	6		5		4		3		2		1		
3													
4	7		8		9		10		11		12		
5													
6	18		17		16		15		14		13		
7													
8	19		20		21		22		23		24		
9													
10	30		29		28		27		26		25		
11													
12	31		32		33		34		35		36		
13													

F-11A. Description of original monument and accessories and/or subsequent restoration:

Calvin Britian D.S. 1832	Liber 1, Page 85
West between Sections 28 & 33	John P. Clapp September 21, 1971
40 chains set $\frac{1}{2}$ mile post	Found 2" iron & stone
18" Hemlock is Post	Raised with angle iron
No witness's given	Power pole SE 126.68
	Twin 8" Aspen SW 50.60
	4" Oak NW 49.90
	28" Maple SW 30.33


Liber 3, Page 222
 Thomas E. Joiner November 14, 1977
 Found angle iron, 2" pipe, stone
 placed with cast iron monument
 14" Oak N 76.73
 Power Pole SE 126.74
 Twin 8" Ash SSW 59.60
 6" Ash SW 67.54

B. Description of corner evidence found and/or method applied in restoring or reestablishing corner:

F-11
 Found Cast Iron Monument and accepted as a careful and faithful perpetuation of the position of the original corner.

Liber 1 Page 85	Liber 3 Page 222
Power Pole SE 126.68	Power Pole SE 126.74
28" Maple SW 30.33	8" Twin Ash SSW 59.60
	6" Ash SW 67.54

Cast Iron Monument is 0.50'± below existing gravel road.

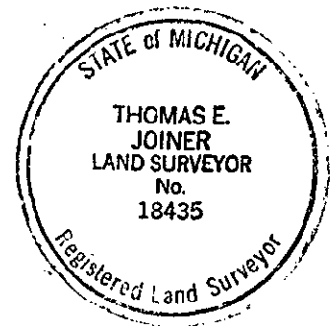

P.A. 345 OTTAWA COUNTY
 PEER APPROVED 12-9-96

C. Description of monument for corner and accessories established to perpetuate localizing the position of the corner:

F-11
 Cast Iron Monument

Ottawa County Remon tag and nail in W side 16" Oak	AZ 335°	Dist 50.24
Ottawa County Remon tag and nail in E side 16" Oak	AZ 10°	Dist 33.52
Ottawa County Remon tag and nail in NW side 30" Maple	AZ 240°	Dist 31.52
Ottawa County Remon tag and nail in E side triple 12" Ash	AZ 180°	Dist 42.08

Signed by Thomas E. Joiner Date 12-6-96
 Surveyor's Michigan License No. 18435