

**SURVEY &  
REMONUMENTATION**

APR 05 1996

OTTAWA COUNTY REMONUMENTATION  
**LAND CORNER RECORDATION CERTIFICATE**  
Filing Requirement of Act 74, Mich. P.A. 1970

**COMMISSION**

For corners in

<u>Ottawa</u> (County)	Located In:	Corner Code #
1. Public Land Survey	T <u>7N</u> R <u>16W</u>	F-13 S $\frac{1}{4}$ corner Section 33 Grand Haven Twp
	T _____ R _____	_____
	T _____ R _____	_____
	T _____ R _____	_____
2. Property Controlling in Section	S _____ T _____ R _____	_____
	S _____ T _____ R _____	_____
3. Miscellaneous Property in Sec.	S _____ T _____ R _____	_____
	S _____ T _____ R _____	_____

**RECORDED**

95 NOV 29 PM 1:40

*D. J. ...*  
REGISTER OF DEEDS  
OTTAWA COUNTY, MI

Register of Deeds Stamp & File Number

4. Lot No. \_\_\_\_\_, Recorded Plat \_\_\_\_\_  
5. Private Claims \_\_\_\_\_

1. THOMAS E. JOINER, in a field survey on 11-7-, 19 95, do hereby certify that under requirements of P.A. 74, Michigan P.A. of 1970, the corner points mentioned in lines 1 and 2 above were in conformance with regulations and rules therefore as required in the current manual of survey instructions of the United States Department of the Interior, Bureau of Land Management or by a decree of a Court of Law and/or that the corner points mentioned in lines 3, 4 and 5 above were in conformance with the rules of the Michigan Board of Land Surveyors or by a Decree of a Court of Law; established, re-established, monumented, re-monumented, recovered, found as expressed below:

**NOTE: Not more than 4 corners, all in the same town and range, may be recorded on this certificate.**

A	B	C	D	E	F	G	H	I	J	K	L	M
2	6	5	4	3	2	1						
3												
4	7	8	9	10	11	12						
5												
6	18	17	16	15	14	13						
7												
8	19	20	21	22	23	24						
9												
10	30	29	28	27	26	25						
11												
12	31	32	33	34	35	36						
13												

**A. Description of original monument and accessories and/or subsequent restoration:**

05-09-1832	Liber 2 Page 723, 01-14-75	Liber 4 Page 10 12-11-79
Post Set By Calvin Britain D.S.	Found Pipe	Found Iron Pipe
N 70° E 11 6" Hemlock	NW 37.77 MBT Box	Set Cast Iron Monument
N 04° W 8 5" Hemlock	NW 40.33 14" Oak	NW 38.4 MBT Box
	NE 25.60 24" Beech	SW 39.94 Triple 11" Beech
	ESE 59.29 24" Oak	S 27.51 17" Maple
	ENE 61.00 30" Pine	NE 25.29 24" Beech
	W 53.48 N $\frac{1}{4}$ corn, Sect 4, Port Sheldon Twp.	

**B. Description of corner evidence found and/or method applied in restoring or reestablishing corner:**

Found Cast Iron Monument in Monument Box and accepted as a careful and faithful perpetuation of the position of the original corner.


Liber 2 Page 723 01-14-75	Liber 4 Page 10 12-10-79
NW 37.77 MBT Box	NE 25.29 24" Beech
NE 25.60 24" Beech	NW 38.40 MBT Box
ENE 61.0 30" Pine	
W 53.48 N $\frac{1}{4}$ Corner (Sect. 4, Port Sheldon Twp)	

PA. 345 OTTAWA COUNTY  
PEER APPROVED 11/20/95

*Madison D. ...*

**C. Description of monument for corner and accessories established to perpetuate locating the position of the corner:**

Cast Iron Monument				
O.C. Remon Tag & Nail in SE side	26" Beech	AZ. 24°	25.90	
O.C. Remon Tag & Nail in NW side	21" Oak	AZ. 41°	72.33	
O.C. Remon Tag & Nail in SW side	24" Oak	AZ. 115°	34.47	
O.C. Remon Tag & Nail in W side	18" Oak	AZ. 188°	28.11	

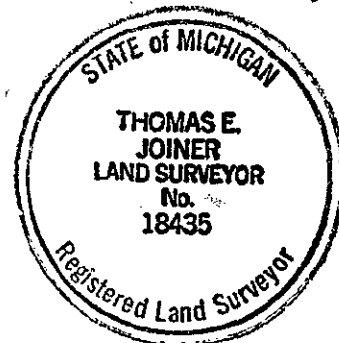

Signed by Thomas E. Joiner  
Surveyor's Michigan License No. 18435

Date 11-16-95