

**SURVEY &  
REMONUMENTATION**

APR 05 1996

**OTTAWA COUNTY REMONUMENTATION  
LAND CORNER RECORDATION CERTIFICATE  
Filing Requirement of Act 74, Mich. P.A. 1970**

For corners in **COMMISSION**

Ottawa (County)	Located In:	Corner Code #
1. Public Land Survey	T <u>7N</u> R <u>16W</u>	G-1, NE Corner Section 4 Grand Haven Twp
2. Property Controlling in Section	S ___ T ___ R ___	___
3. Miscellaneous Property in Sec.	S ___ T ___ R ___	___

RECORDED

95 NOV 29 PM 1:40

*Edythe Williams*  
REGISTER OF DEEDS  
OTTAWA COUNTY, MI

Register of Deeds Stamp & File Number

4. Lot No. \_\_\_\_\_, Recorded Plat \_\_\_\_\_  
5. Private Claims \_\_\_\_\_

	A	B	C	D	E	F	G	H	I	J	K	L	M
2	6		5		4		3		2		1		
3													
4	7		8		9		10		11		12		
5													
6	18		17		16		15		14		13		
7													
8	19		20		21		22		23		24		
9													
10	30		29		28		27		26		25		
11													
12	31		32		33		34		35		36		
13													

I, Thomas E. Joiner, in a field survey on 11/9, 19 95, do hereby certify that under requirements of P.A. 74, Michigan P.A. of 1970, the corner points mentioned in lines 1 and 2 above were in conformance with regulations and rules therefore as required in the current manual of survey instructions of the United States Department of the Interior, Bureau of Land Management or by a decree of a Court of Law and/or that the corner points mentioned in lines 3, 4 and 5 above were in conformance with the rules of the Michigan Board of Land Surveyors or by a Decree of a Court of Law; established, re-established, monumented, re-monumented, recovered, found as expressed below:

**NOTE: Not more than 4 corners, all in the same town and range, may be recorded on this certificate.**

**A. Description of original monument and accessories and/or subsequent restoration:**

05-22-1832	Liber 2, Page 655	10-9-74	Liber 5, Page 266	01-16-87
Post Set By Calvin Britain, D.S.	Found 1" Pipe		Found Cast Iron Monument	
S 38°E 15 12" Hemlock	NW Guy Pole	121.16	Spring Lake Cor.	E 54.48
S 75°W 27 5" Hemlock	Liber 4, Page 299	04-01-82	Power Pole	NW 38.59
	Found Iron Pipe		Q Top of Hydrant	WNW 66.04
	Telephone Pole	NW 38.58	Power Pole	SW 65.41
	Power Pole	SE 69.00		
	13" Poplar	SW 57.09		
	Spring Lake cor.	E 54.52		

**B. Description of corner evidence found and/or method applied in restoring or reestablishing corner:**

Found Cast Iron Monument in Monument Box and accepted as a careful and faithful perpetuation of the position of the original corner.

Liber 4, Page 299	Liber 5, Page 266
Telephone Pole NW 38.58	Spring Lake Cor. E 54.48
Power Pole SW 57.09	Power Pole NW 38.59
Spring Lake Cor. E 54.52	Q Top of Hydrant WNW 66.04
	Power Pole SW 65.41


P.A. 345 OTTAWA COUNTY

PEER APPROVED 11/20/95

*Thomas E. Joiner*

**C. Description of monument for corner and accessories established to perpetuate locating the position of the corner:**

Cast Iron Monument		
Q Top Operating Bolt on Hydrant	AZ 295°	66.04
Spring Lake Township Corner	AZ 92°	54.48
Easterly Corner of 9.8 X 0.8 Conc. Base Sign	AZ 232°	89.00
O.C. Remon Tag & Nail in E side 36" Ash	AZ 348°	73.15
O.C. Remon Tag & Nail in SW side Power Pole	AZ 130°	69.70

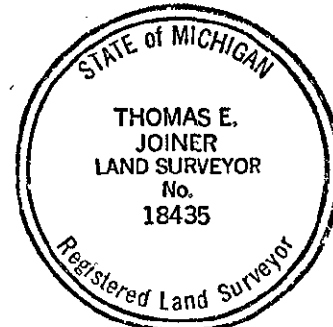

Signed by Thomas E. Joiner

Date 11-16-95

Surveyor's Michigan License No. 18435