

SURVEY &  
REMONUMENTATION

APR 05 1996

OTTAWA COUNTY REMONUMENTATION  
LAND CORNER RECORDATION CERTIFICATE  
Filing Requirement of Act 74, Mich. P.A. 1970

COMMISSION

For corners in

Ottawa (County)	Located In:	Corner Code #
1. Public Land Survey	T <u>7N</u> R <u>16W</u>	G-3, SE corner Section 4 Grand Haven Twp
	T ___ R ___	_____
	T ___ R ___	_____
	T ___ R ___	_____
2. Property Controlling in Section	S ___ T ___ R ___	_____
	S ___ T ___ R ___	_____
3. Miscellaneous Property in Sec.	S ___ T ___ R ___	_____
	S ___ T ___ R ___	_____

RECORDED

95 NOV 29 PM 1:40

*Phyllis Kellerman*  
REGISTER OF DEEDS  
OTTAWA COUNTY, MI

Register of Deeds Stamp & File Number

4. Lot No. \_\_\_\_\_, Recorded Plat \_\_\_\_\_  
5. Private Claims \_\_\_\_\_

	A	B	C	D	E	F	G	H	I	J	K	L	M
2	6	5	4	3	2	1							
3							●						
4	7	8	9	10	11	12							
5													
6	18	17	16	15	14	13							
7													
8	19	20	21	22	23	24							
9													
10	30	29	28	27	26	25							
11													
12	31	32	33	34	35	36							
13													

I, Thomas E. Joiner, in a field survey on 11/9, 19 95, do hereby certify that under requirements of P.A. 74, Michigan P.A. of 1970, the corner points mentioned in lines 1 and 2 above were in conformance with regulations and rules therefore as required in the current manual of survey instructions of the United States Department of the Interior, Bureau of Land Management or by a decree of a Court of Law and/or that the corner points mentioned in lines 3, 4 and 5 above were in conformance with the rules of the Michigan Board of Land Surveyors or by a Decree of a Court of Law; established, re-established, monumented, re-monumented, recovered, found as expressed below:

NOTE: Not more than 4 corners, all in the same town and range, may be recorded on this certificate.

A. Description of original monument and accessories and/or subsequent restoration:

05-22-1832	Liber 1, Page 345	04-10-72
Post Set By Calvin Britain, D.S.	Found Iron Pipe in Pavement	
N 25°W 8 12" Beech	Power Pole SW	56.68
S 26°E 33 10" Beech	Telephone Pole WNW	31.09
	Telephone Pole NE	69.00
	G <sub>L</sub> Street Sign WNW	29.15

B. Description of corner evidence found and/or method applied in restoring or reestablishing corner:


Found Iron Pipe in Pavement and accepted as a careful and faithful perpetuation of the position of the original corner.  
Set Ottawa County Remon Cap Over Iron In Concrete.

Liber 1, Page 345	
Power Pole SW	56.68
Telephone Pole NE	69.00
G <sub>L</sub> Street Sign WNW	29.15

P.A. 345 OTTAWA COUNTY

PEER APPROVED 11/20/95

*Handwritten signatures*

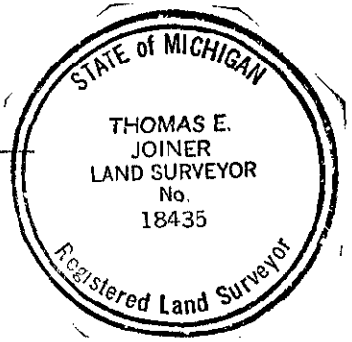

C. Description of monument for corner and accessories established to perpetuate locating the position of the corner:

Ottawa County Remon Cap		
G <sub>L</sub> Operating Bolt on Hydrant	AZ 35°	48.32
O.C. Remon Tag & Nail in SE side Power Pole	AZ 238°	57.38
O.C. Remon Tag & Nail in E side 34" Maple	AZ 344°	100.04
O.C. Remon Tag & Nail in SW side 9" Wild Cherry	AZ 123°	95.85

Signed by Thomas E. Joiner Date 11-16-95  
Surveyor's Michigan License No. 18435